


PERMITTED

SEP 3 1983

WATER RESOURCES DEPT.
SALEM, OREGON

East Tucker Spring

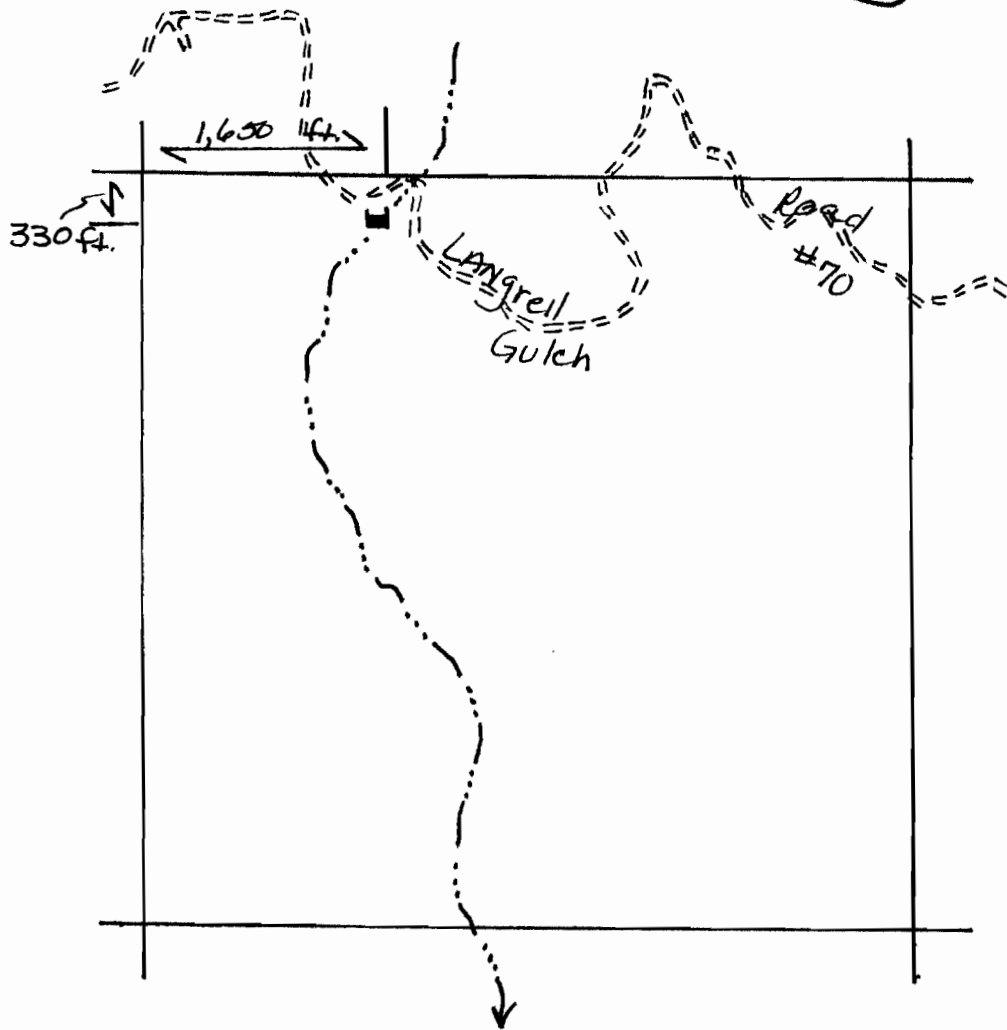

NE $\frac{1}{4}$ NW $\frac{1}{4}$ Sec 14, T. 7S., R. 42E.

Application No. 65949

Permit No. 50472

Scale:

4 inches = 1 mile

