


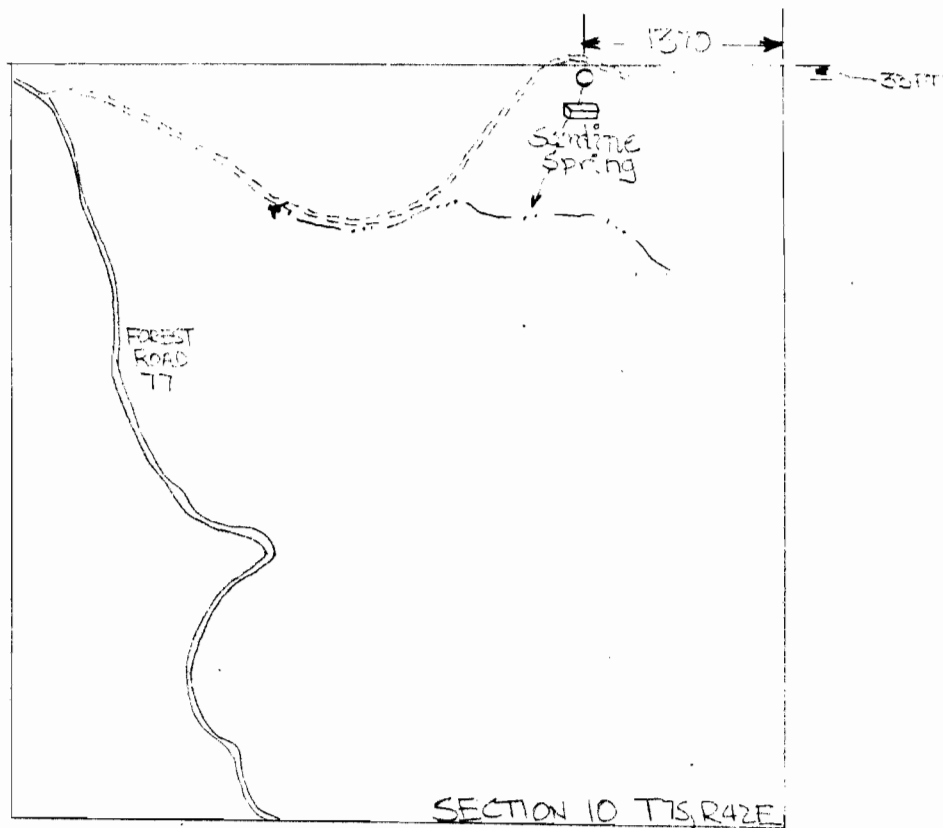



SALEM, OREGON

Application No. 65954
Permit No. 50473