


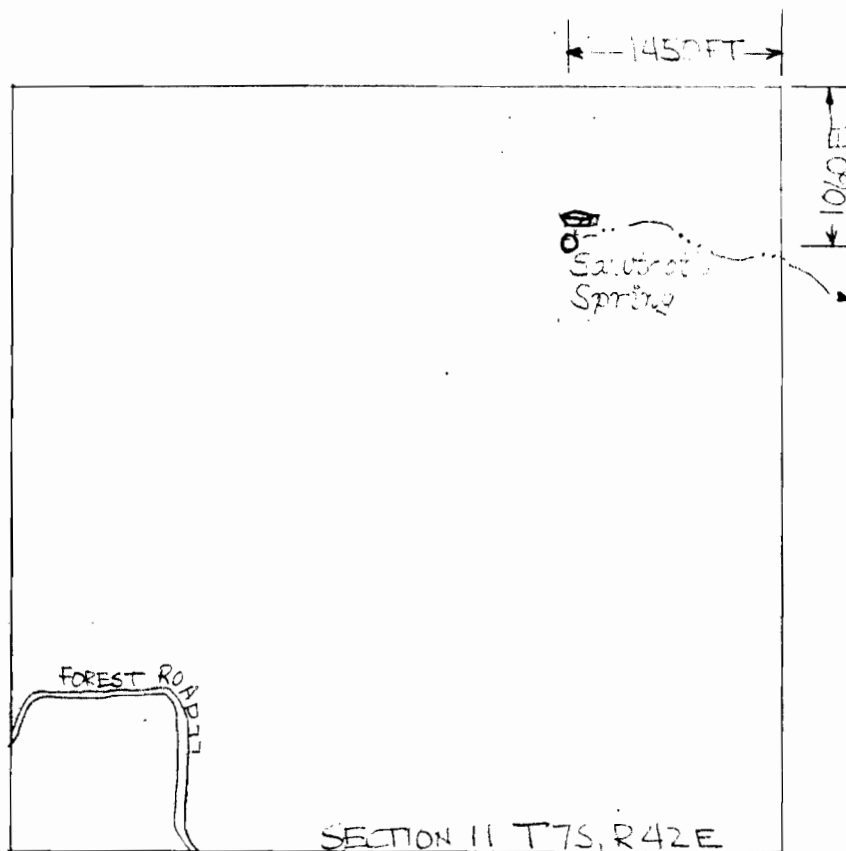

RECEIVED

SEP 3 1933

WILDERNESS DEPT.
SALEM, OREGON

Application No. 65955
Permit No. 50474