



PRINTED

SEP. 3 1983

WATER RESOURCES DEPT.
SALEM, OREGON

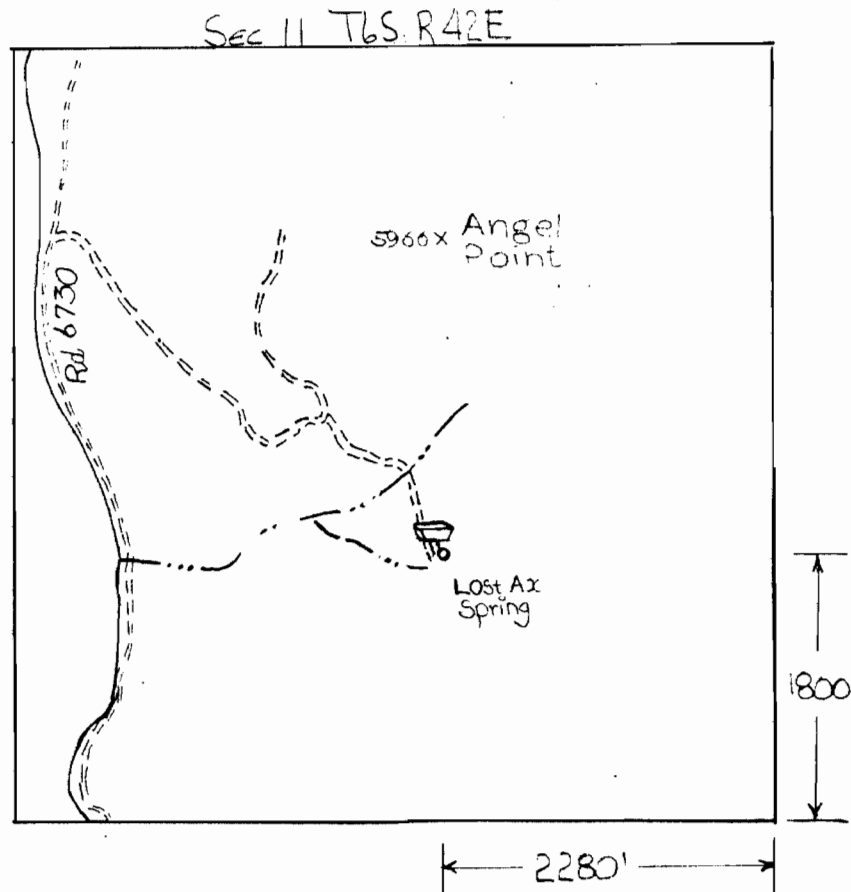

4 INCHES = 1 MILE

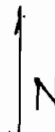

Application No. 65957
Permit No. 50475