


RECEIVED

SEP 13 1933
LAND RESOURCES DEPT.
SALEM, OREGON

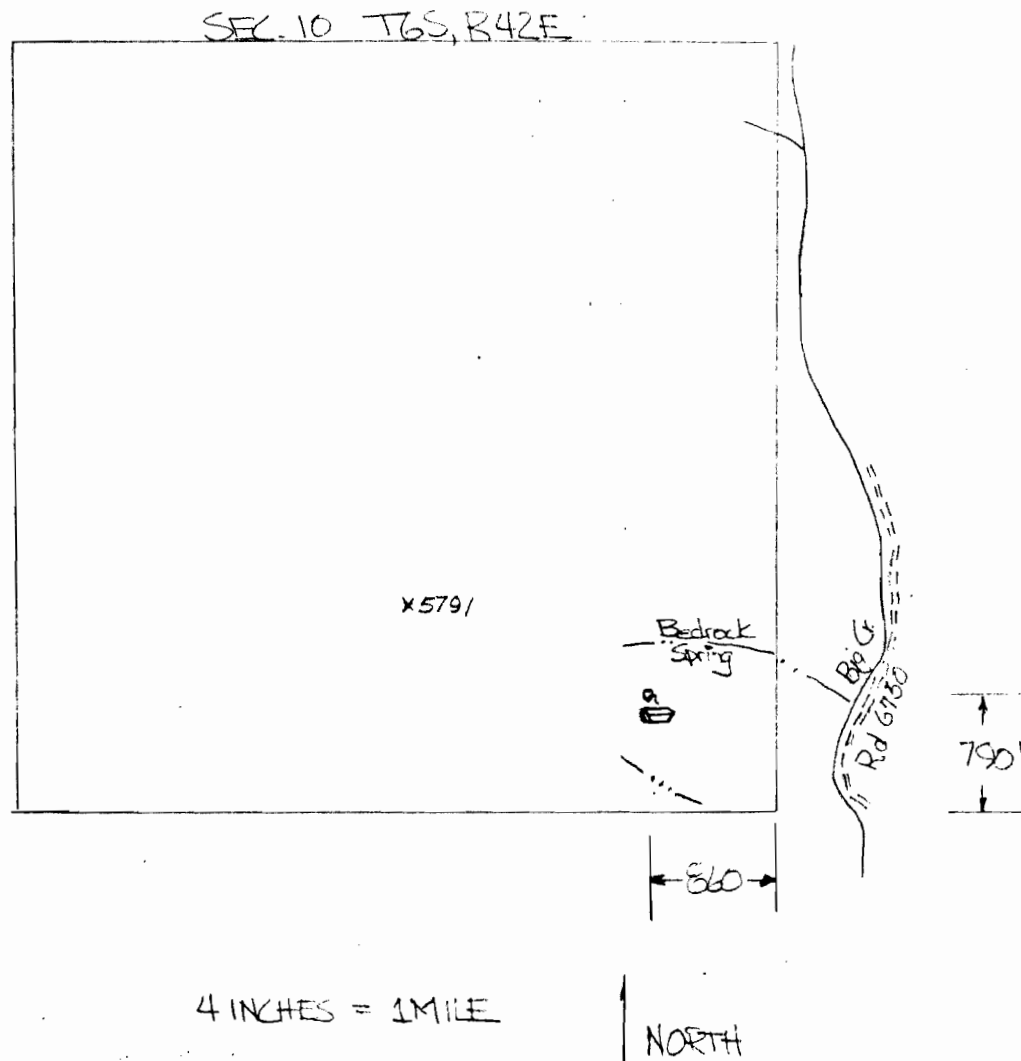

Application No. 65958
Permit No. 50476