
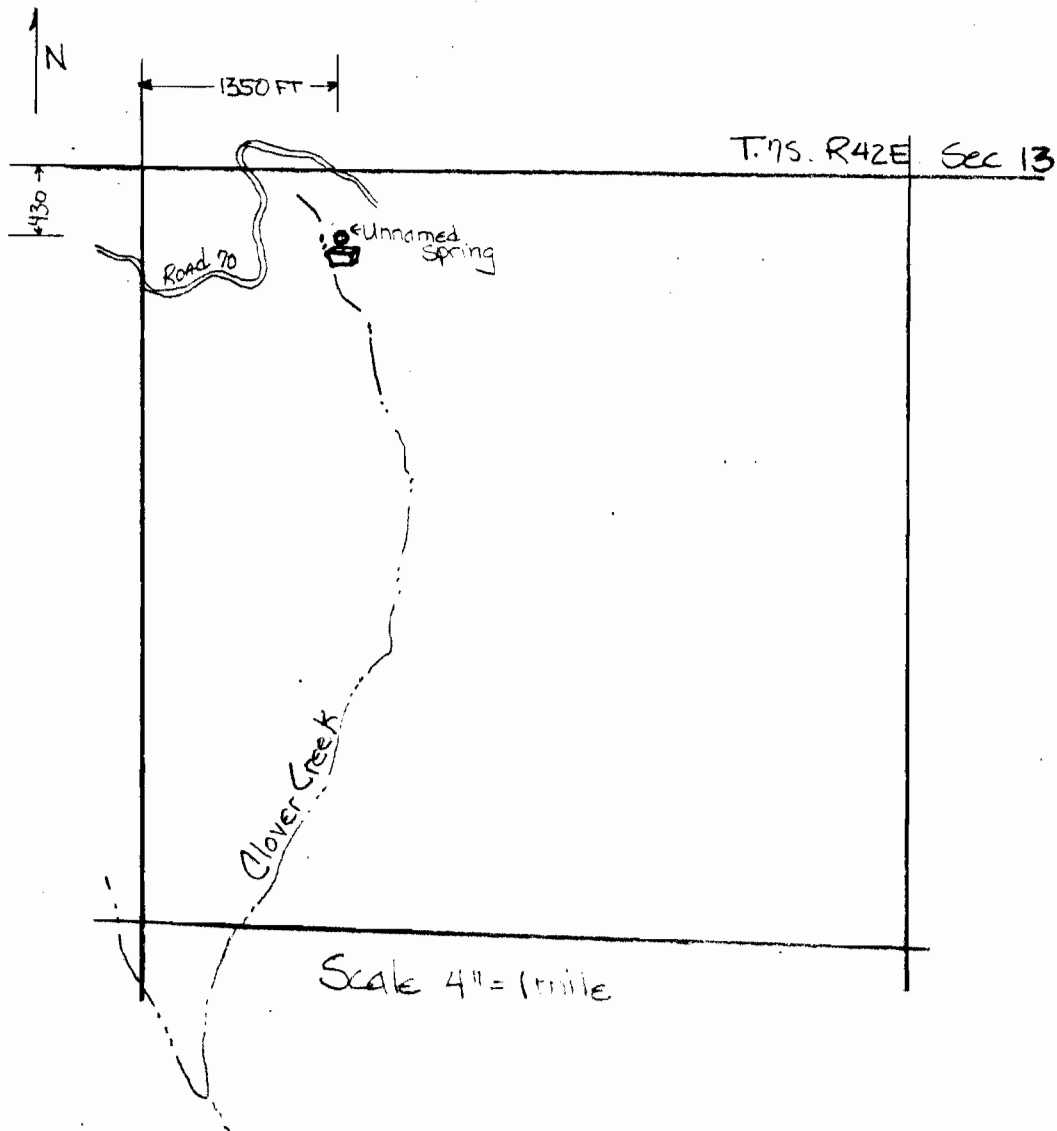


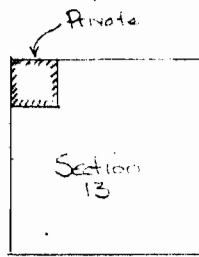

RECEIVED

SEP 3 1933
WILDERNESS DIVISION DEPT.
SALEM, OREGON

Application No. 65961
Permit No. 50478