


RECEIVED

SEP 3 1933
SALEM, OREGON

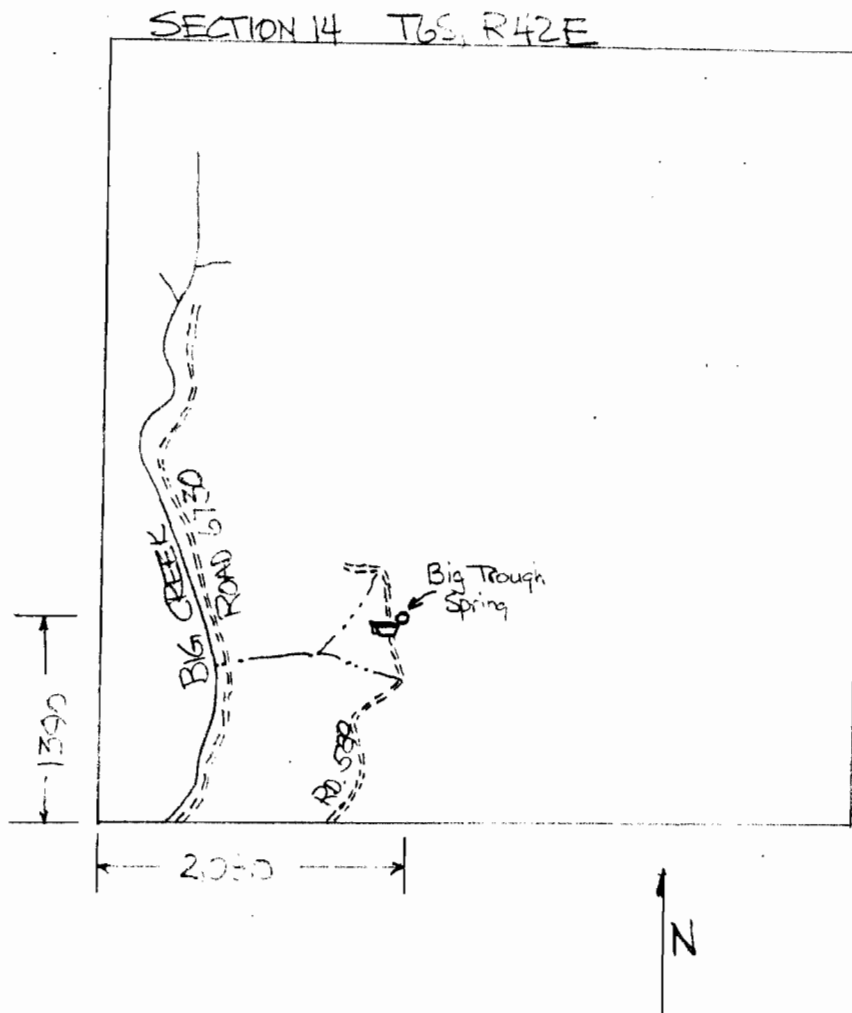

SCALE 4 INCHES = 1 MILE

Application No. 65965
Permit No. 50478