
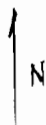


RECEIVED

RECEIVED

SEP 10 1933

LAND OFFICES DEPT.
SALEM, OREGON

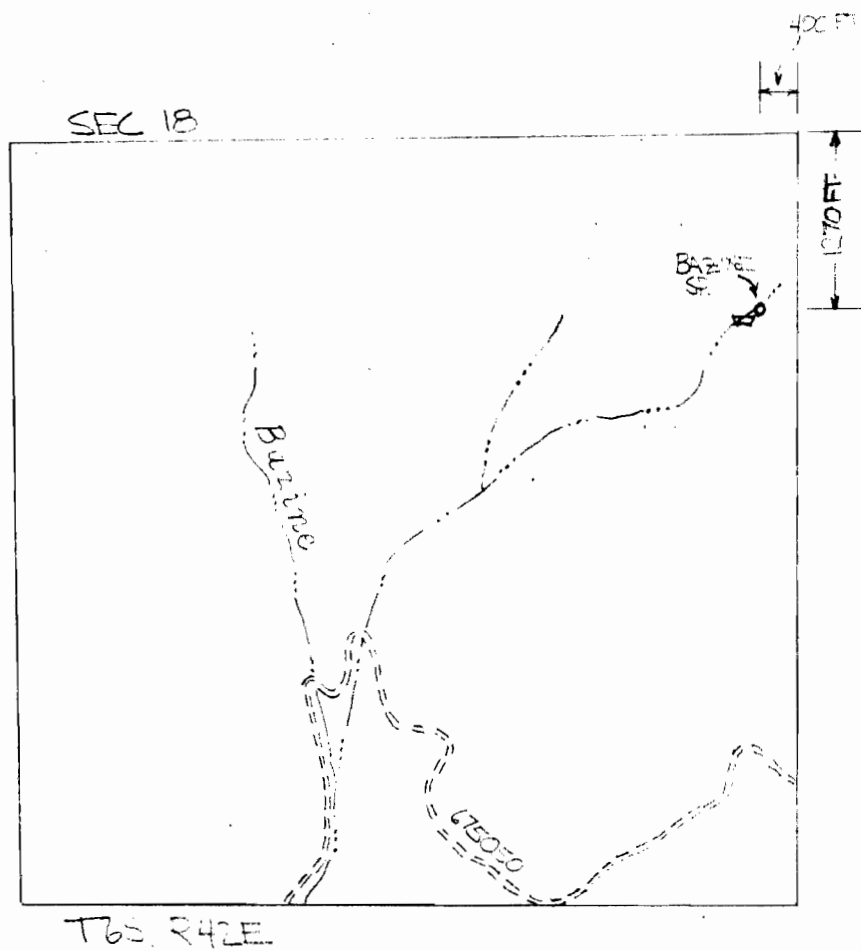

SCALE 4 INCHES = 1 MILE

Application No. 65966
Permit N 50480