


RECEIVED

SEP 14 1983

LAND RESOURCES DEPT.
SALEM, OREGON

Application No. 65910
Permit No. 50495

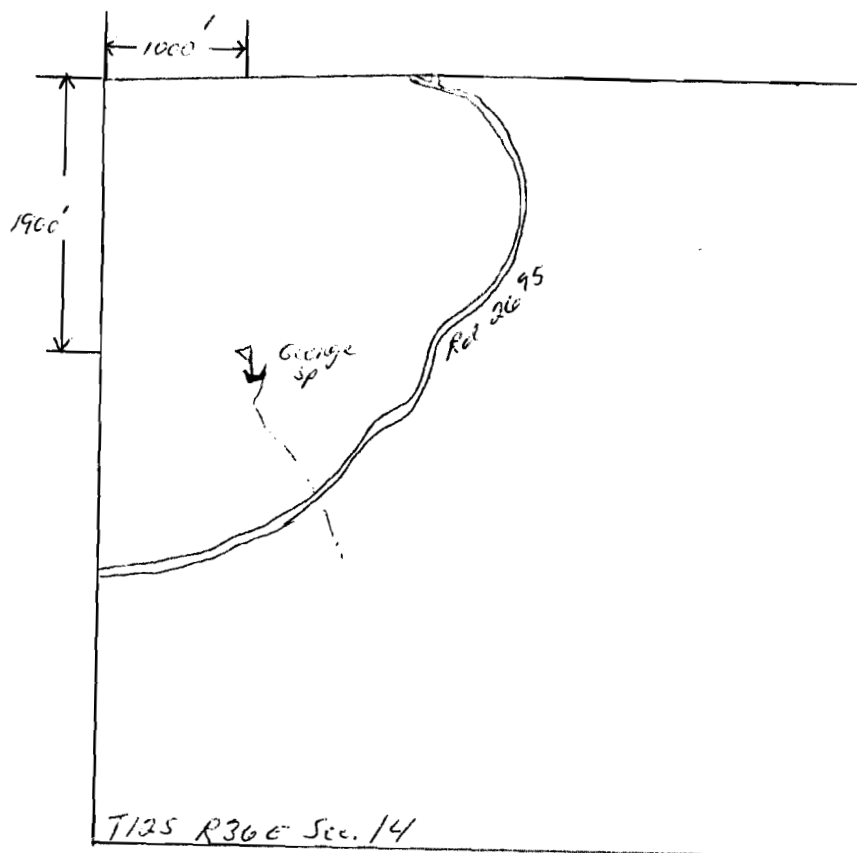

4" = 1 mile

