


4" = 1 mile



RECEIVED

SEP 28 1983

**WATER RESOURCES DEPT.
SALEM, OREGON**

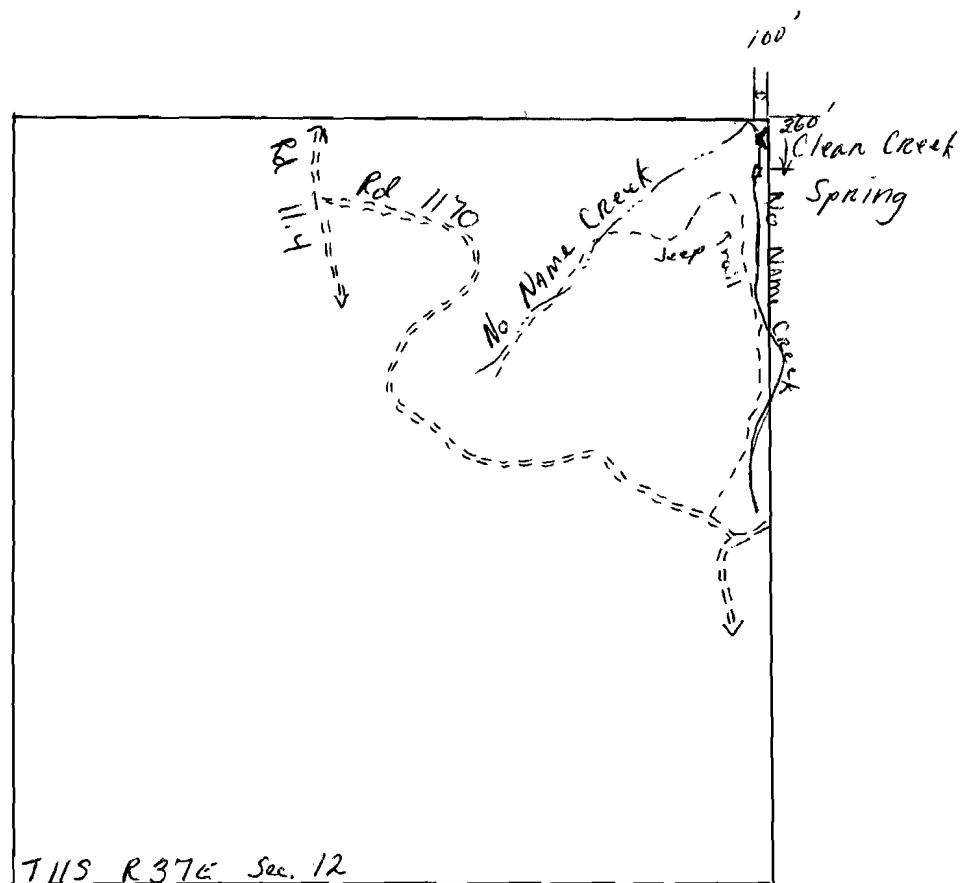

Application No. 65911
Permit No. 50496