


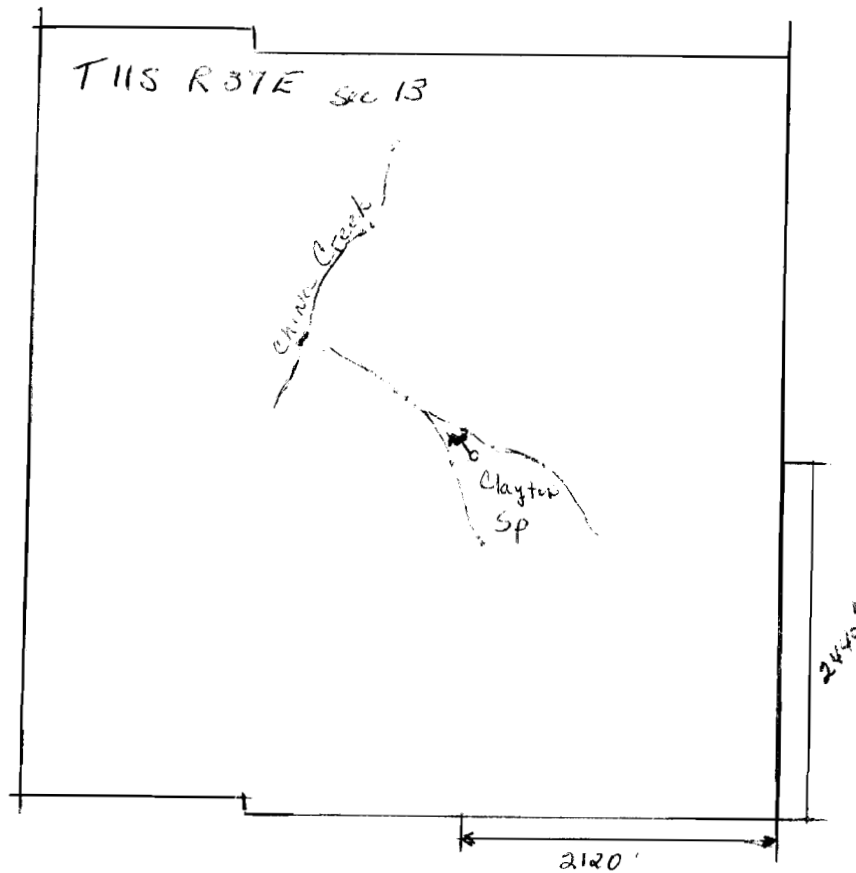

4" = 1 mile



RECEIVED

SEP 6 1983
WATER RESOURCES DEPT.
SALEM, OREGON

Application No. 65912
Permit No. 50497