


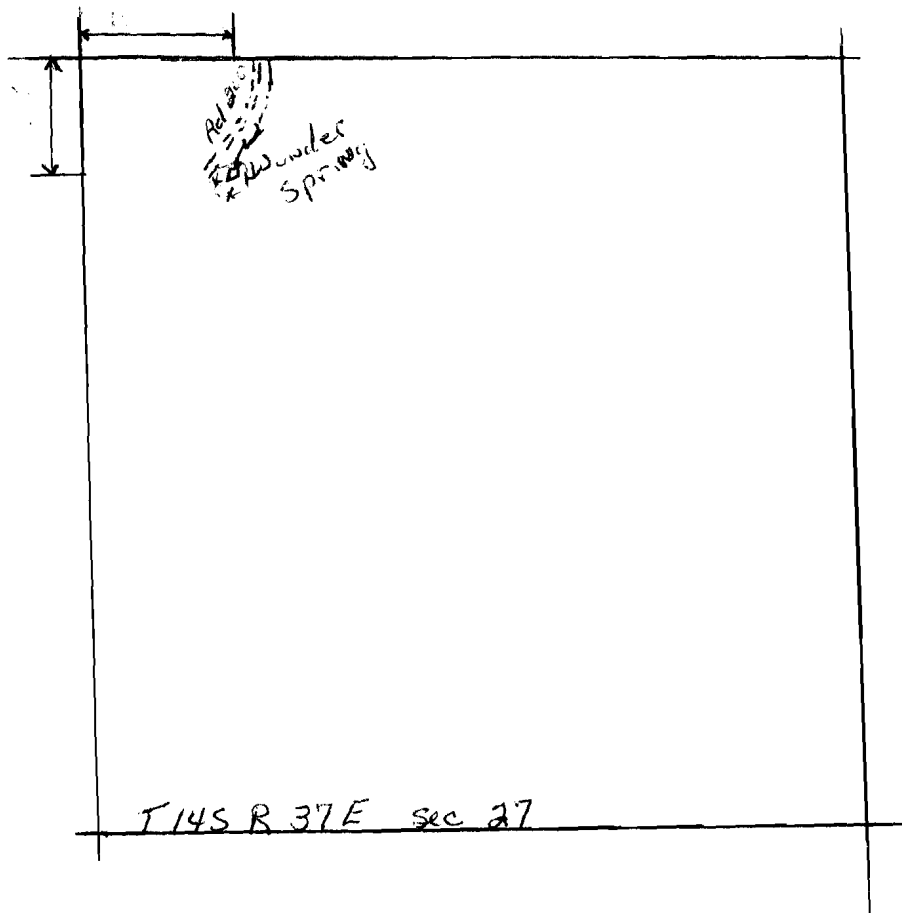


4" = 1 mile



**RECEIVED**

SEP 1983  
WATER RESOURCES DEPT.  
SALEM, OREGON

**Application No. 65913**  
**Permit No. 50498**

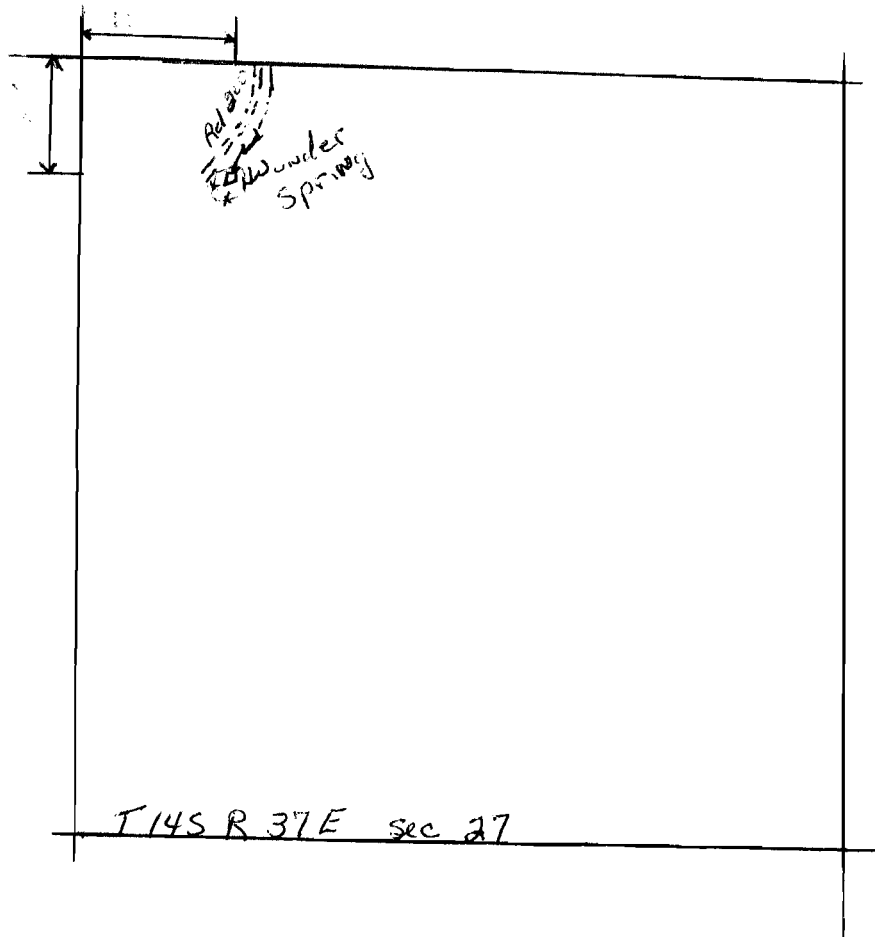

**RECEIVED**

SEP 9 1983

WATER RESOURCES DEPT.  
SALEM, OREGON

**Application No. 65913**  
**Permit No. 50498**