


RECEIVED

JUL 13 1983

WATER RESOURCES DEPT.
SALEM, OREGON

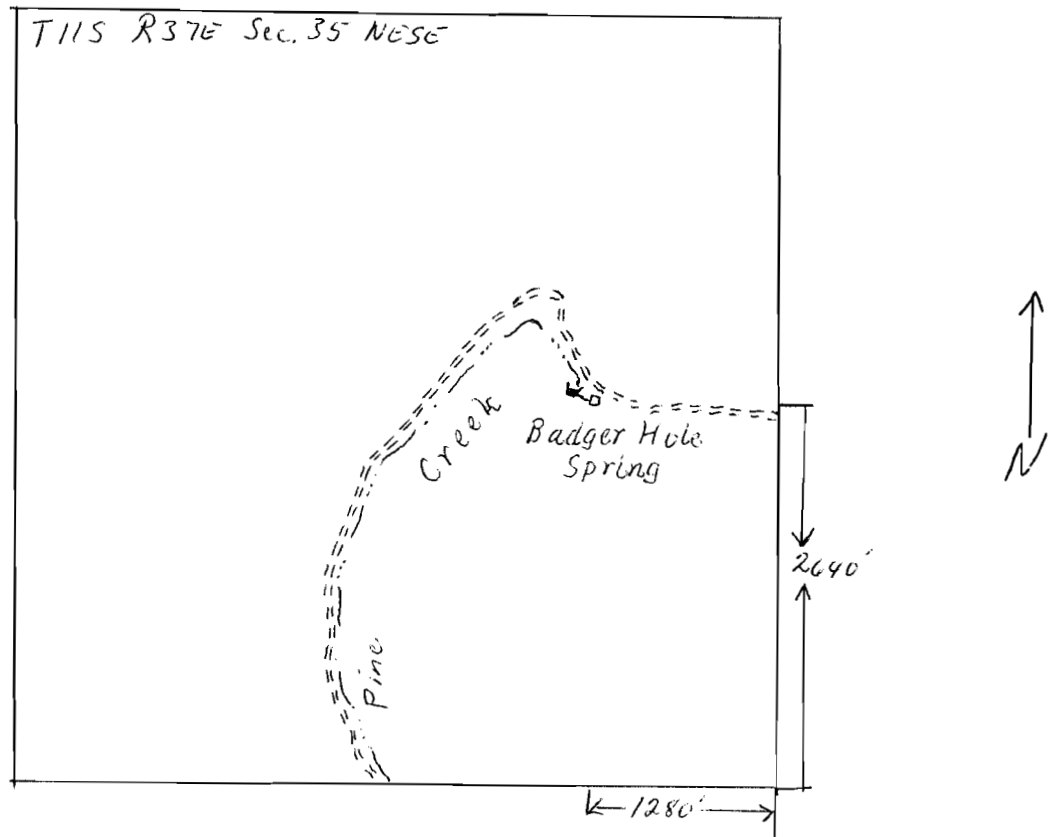

4" = 1 mile

Application No. 65914
Permit No. 50499