


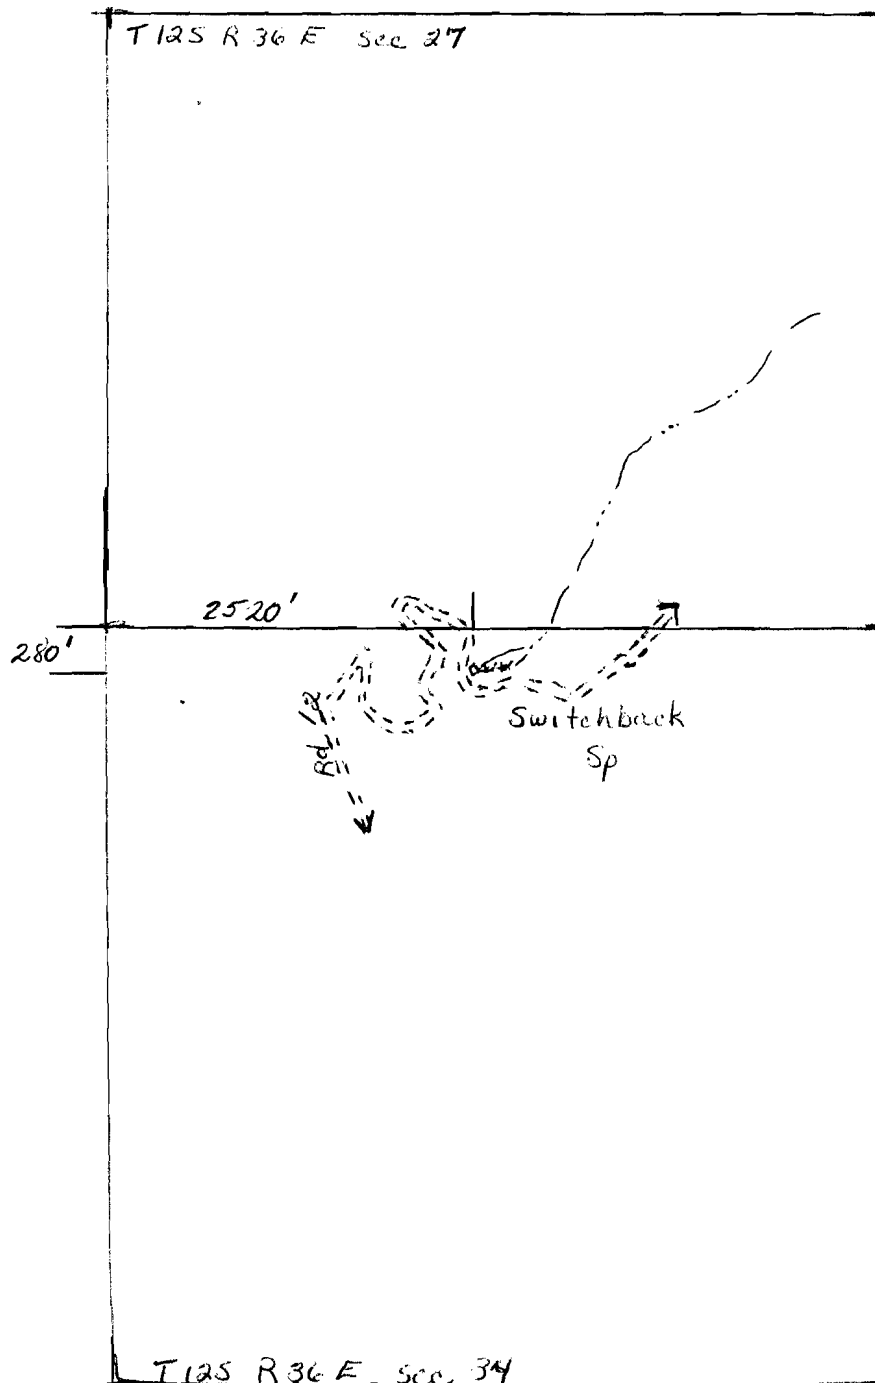

4" = 1 mile

RECEIVED

SEP 15 1983
WATER RESOURCES DEPT.
SALEM, OREGON

Application No. 65915
Permit No. 50500