


FIR TREE SPRING

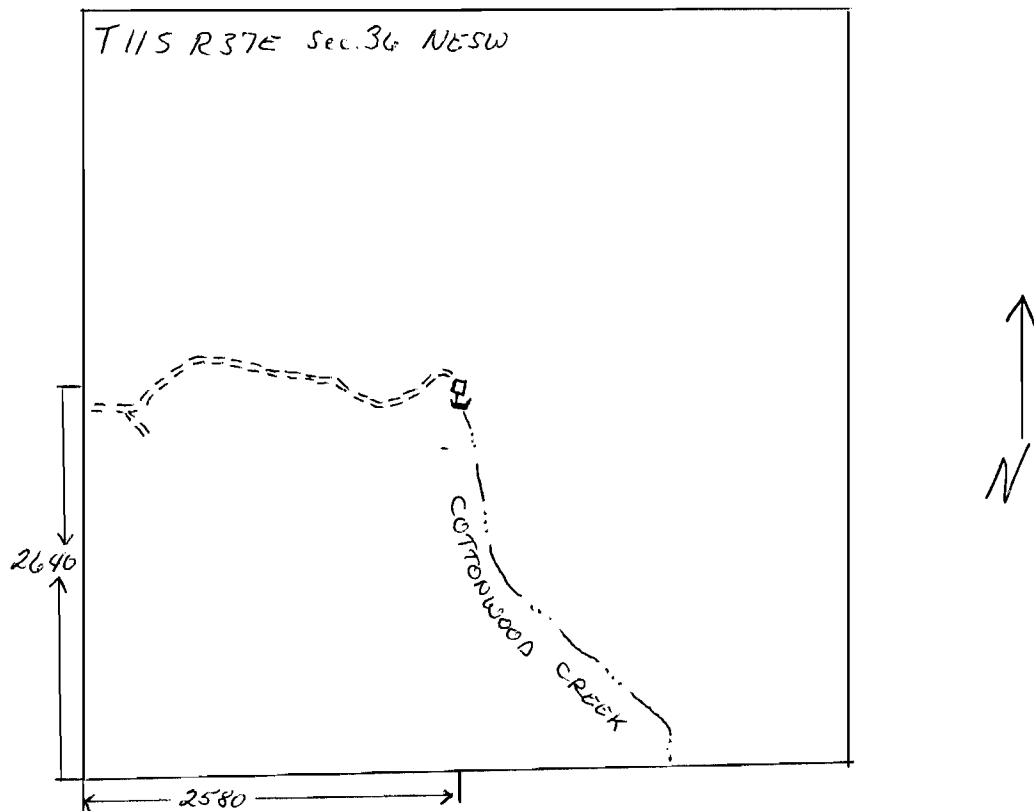

RECEIVED

SEP 5 1983

WATER RESOURCES DEPT.
SALEM, OREGON

4" = 1 mile

Application No. 65916
Permit No. 50501