


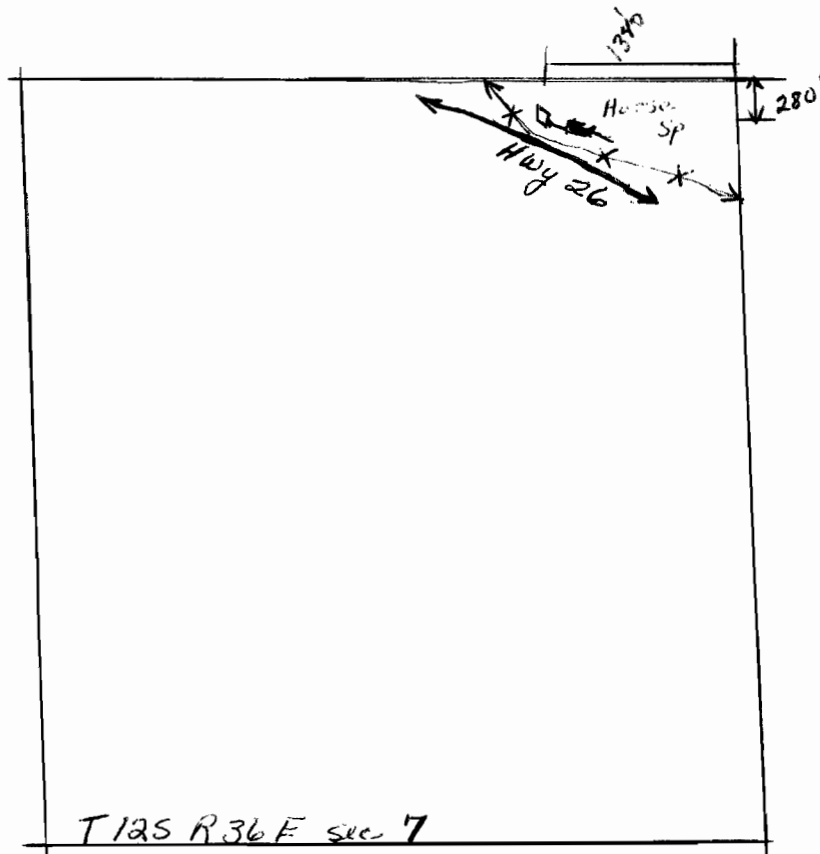

4" = 1 mile



RECEIVED

SEP 8 1983

WATER RESOURCES DEPT.
SALEM, OREGON

Application No. 65917
Permit No. 50502