



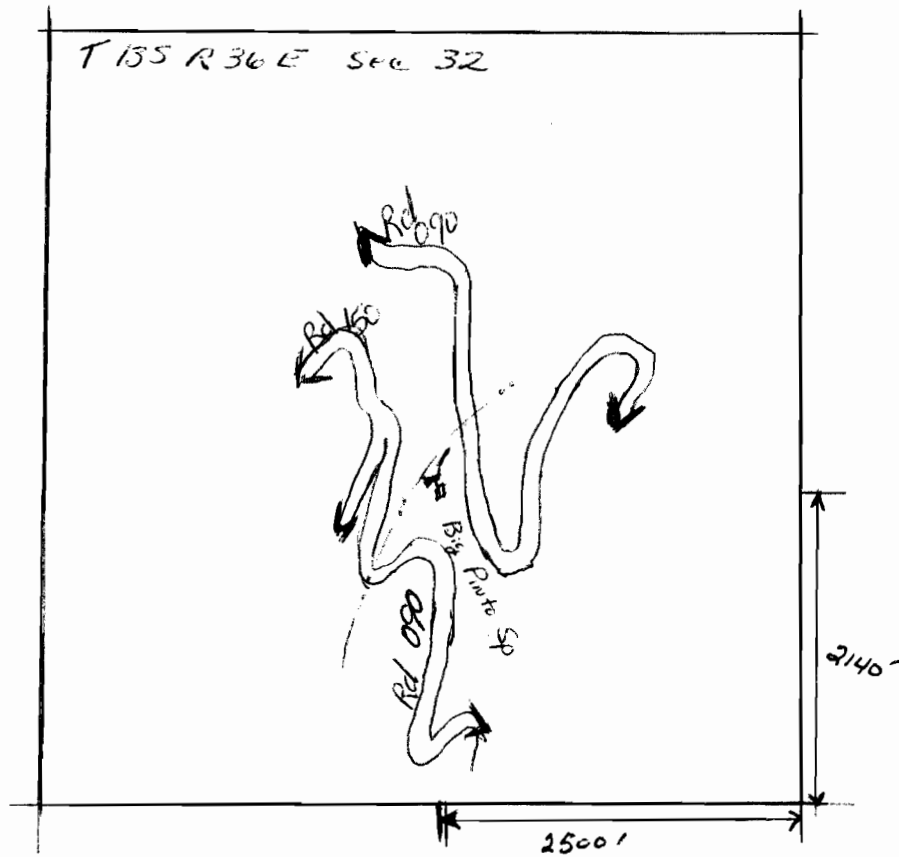

4" = 1 mile

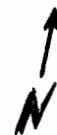

**RECEIVED**

SEP 4 1983

WATER RESOURCES DEPT.  
SALEM, OREGON

**Application No. 65919**  
**Permit No. 50503**