


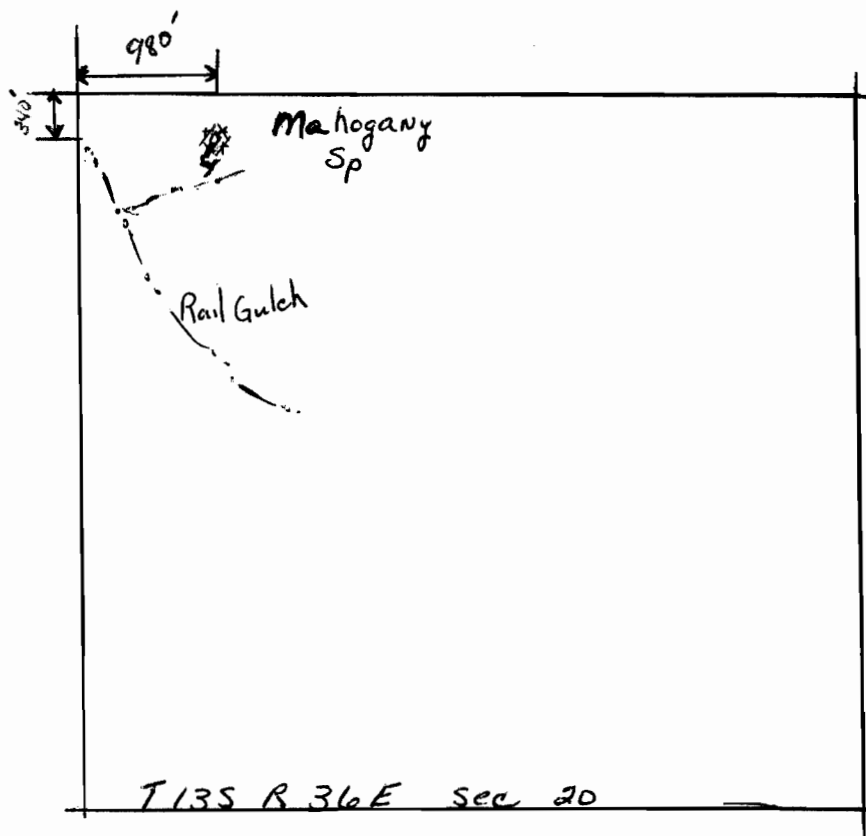

4" = 1 mile



RECEIVED

SEPS 1983

WATER RESOURCES DEPT.
SALEM, OREGON

Application No. 65920
Permit No. 50504