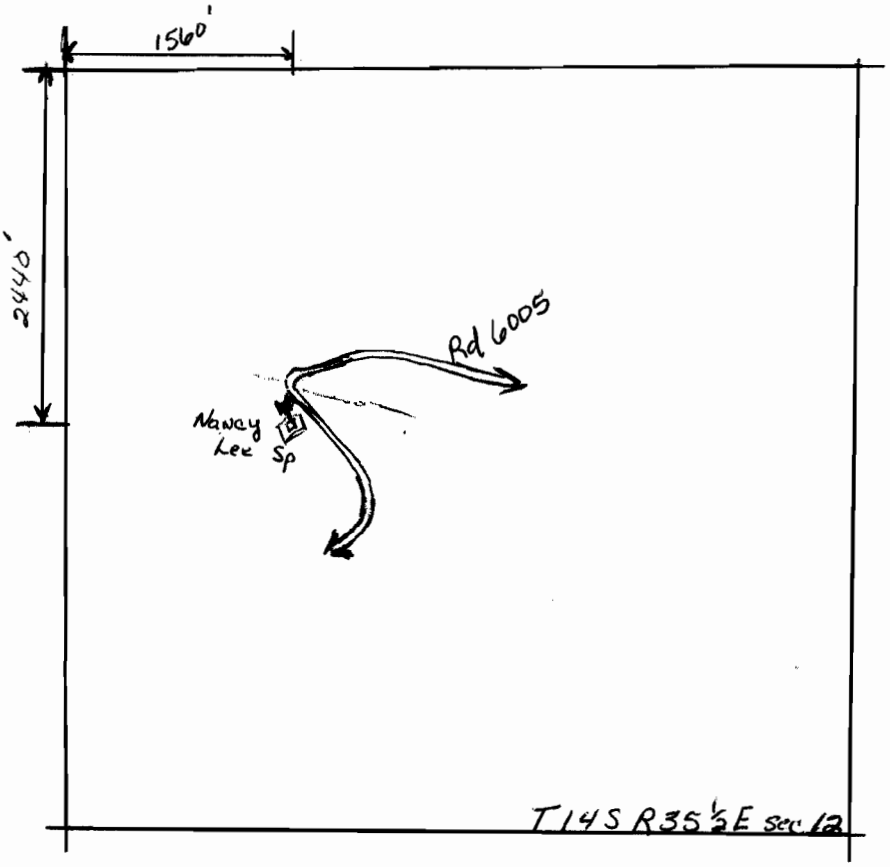

4"=1 mile

N

RECEIVED
SEP 6 1983
WATER RESOURCES DEPT.
SALEM, OREGON

Application No. 65922
Permit No. 50506