


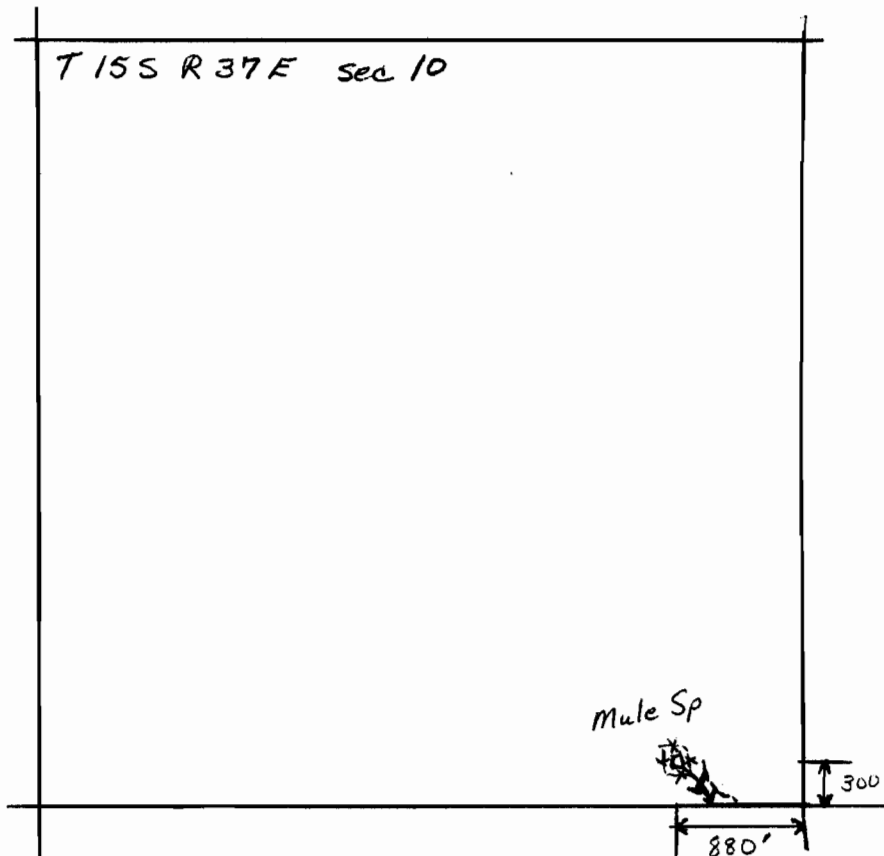

4" = 1 mile



RECEIVED

SEDS 1993
WATER RESOURCES DEPT
SALEM, OREGON

Application No. 65923
Permit No. 50507