


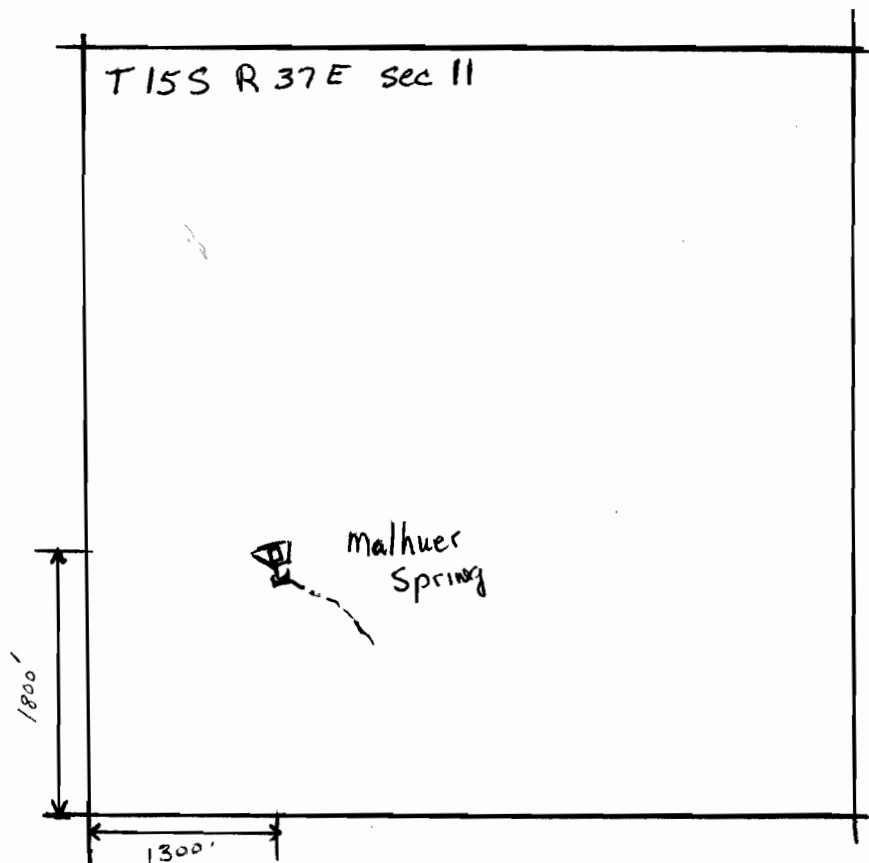

4" = 1 mile



RECEIVED

SEPS 1983

WATER RESOURCES DEPT.
SALEM, OREGON

Application No. 65925
Permit No. 50509