


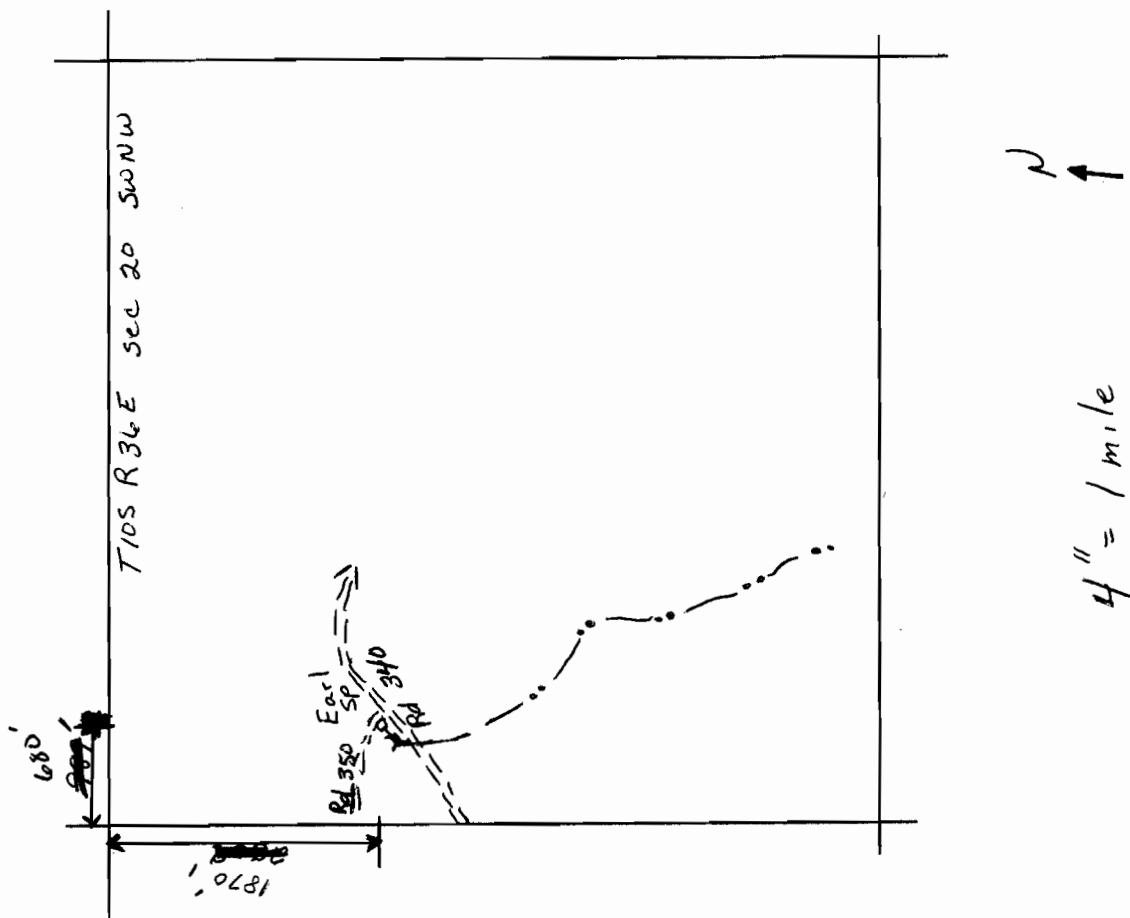

RECEIVED

SEP 6 1983

WATER RESOURCES DEPT.
SALEM, OREGON

Application No. 65927
Permit No. 50511