


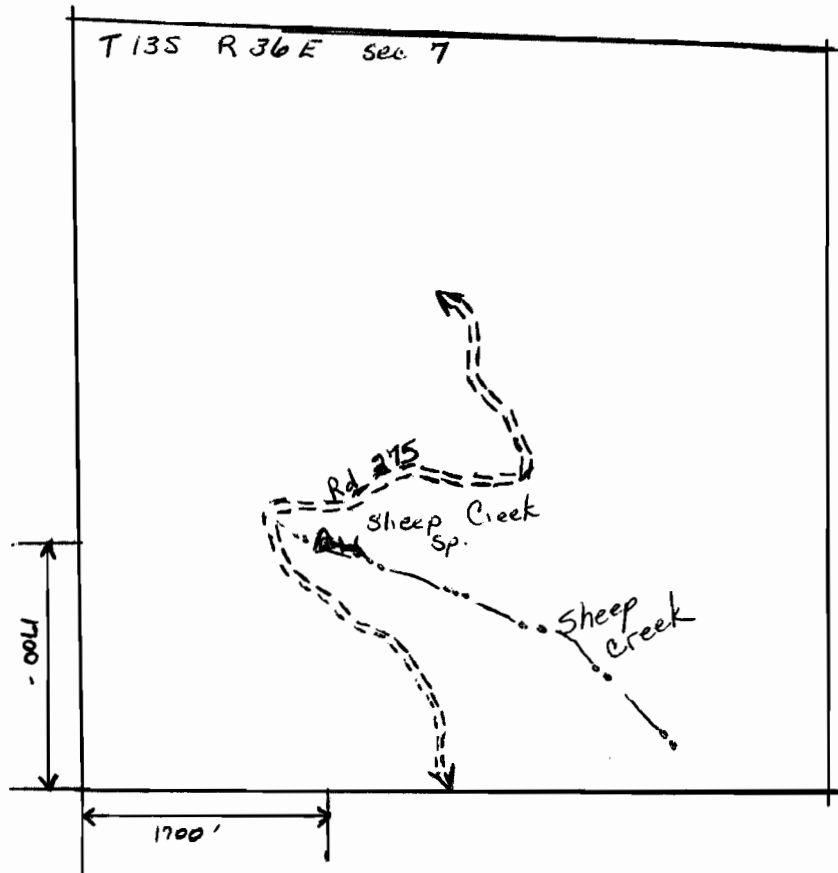

4" = 1 mile



**RECEIVED**

SEP 6 1983  
WATER RESOURCES DEPT.  
SALEM, OREGON

**Application No.** 65928  
**Permit No.** 50512