


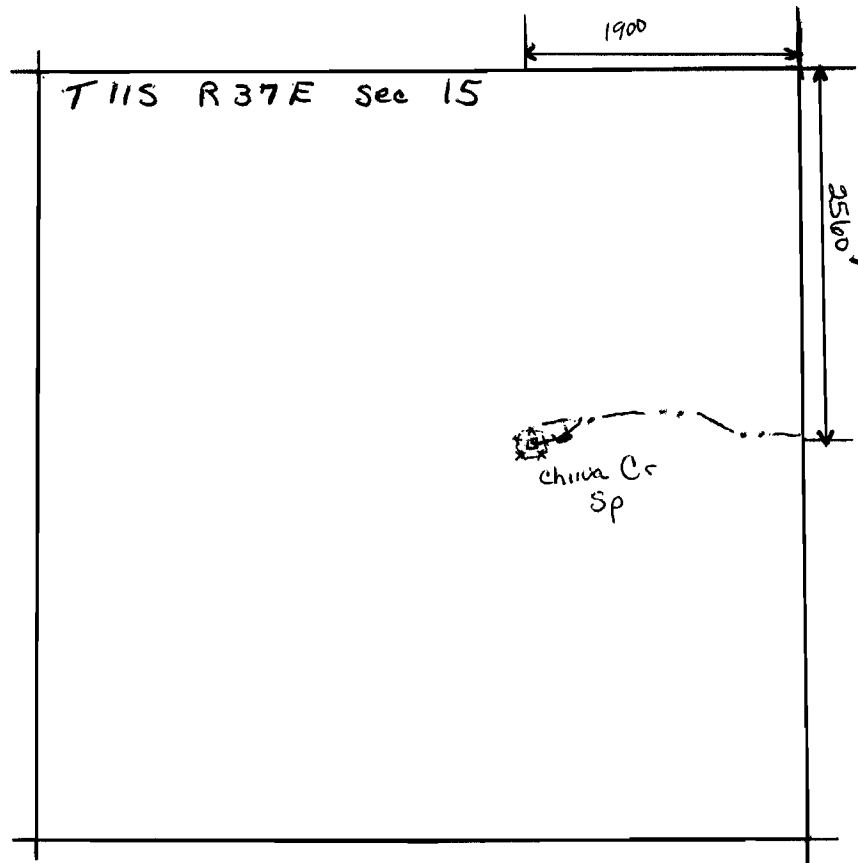

4" = 1 mile



RECEIVED

SEP 6 1983

WATER RESOURCES DEPT.
SALEM, OREGON

Application No. 65932
Permit No. 50516