


4" = 1 mile

N ↓

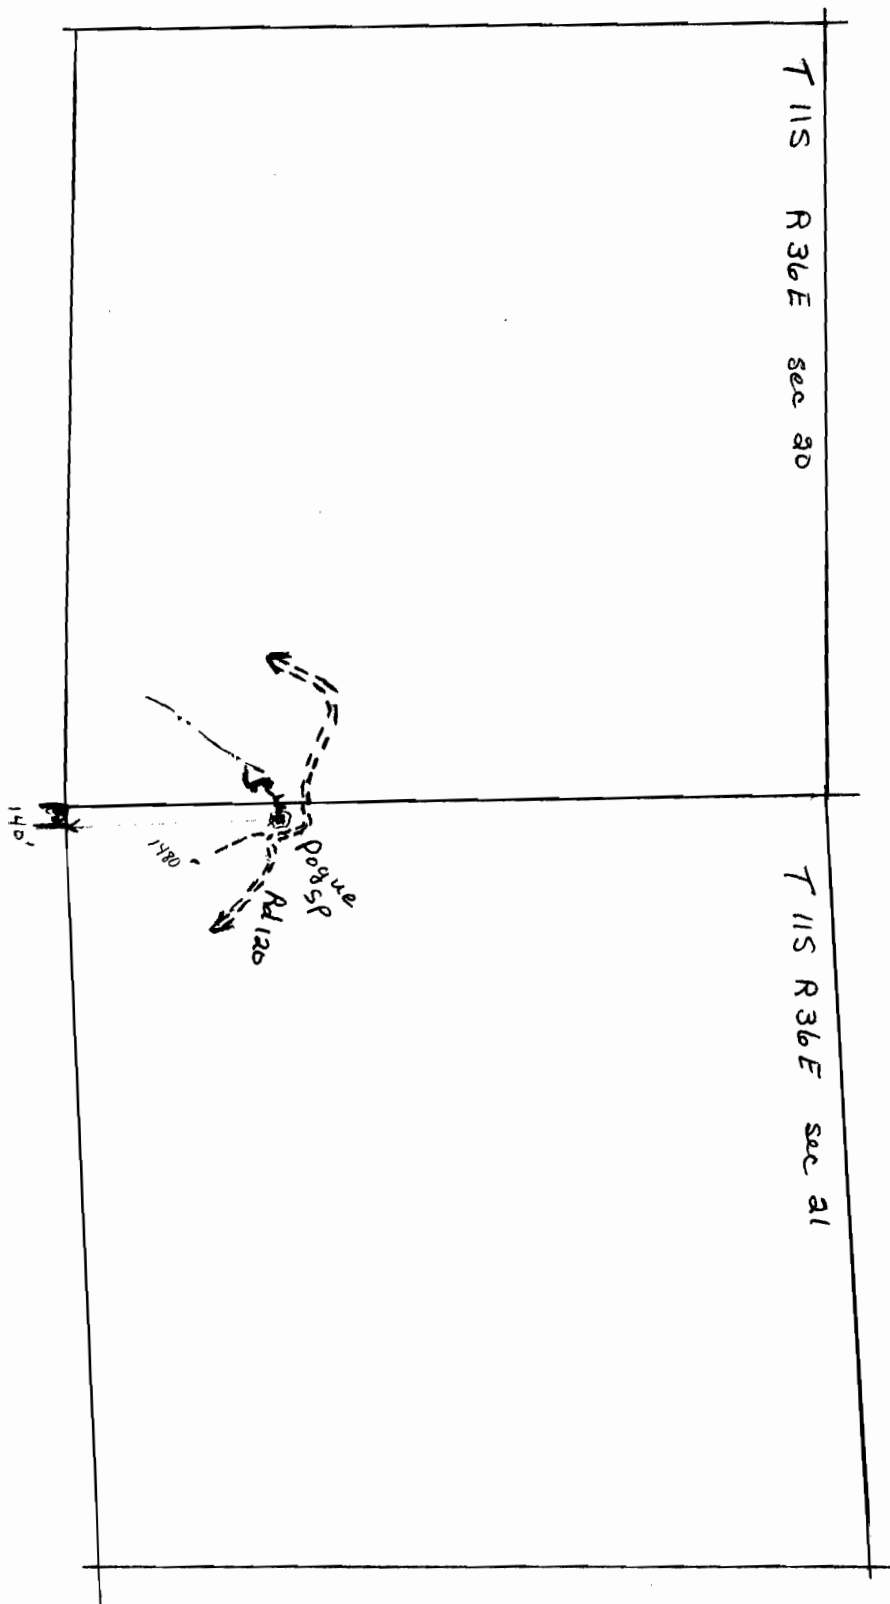

RECEIVED

SEP 6 1983
WATER RESOURCES DEPT.
SALEM, OREGON

Application No. 65935
Permit No. 50519