


Application No. 65905 Permit No. 50545

RECEIVED

DEC 15 1933

WATER RESOURCES DEPT.
SALEM, OREGON

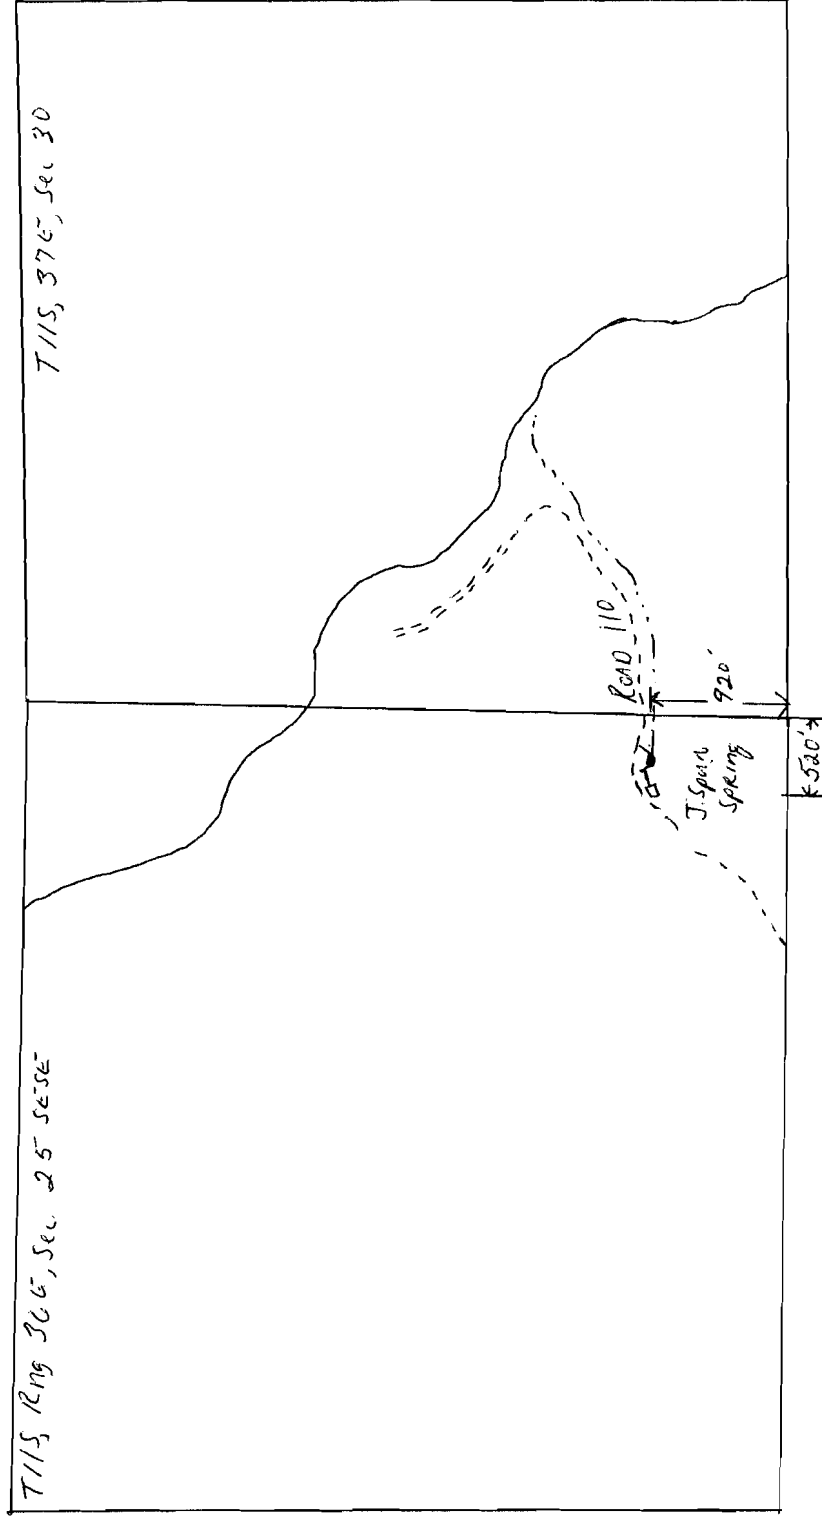

4" = 1 mile