


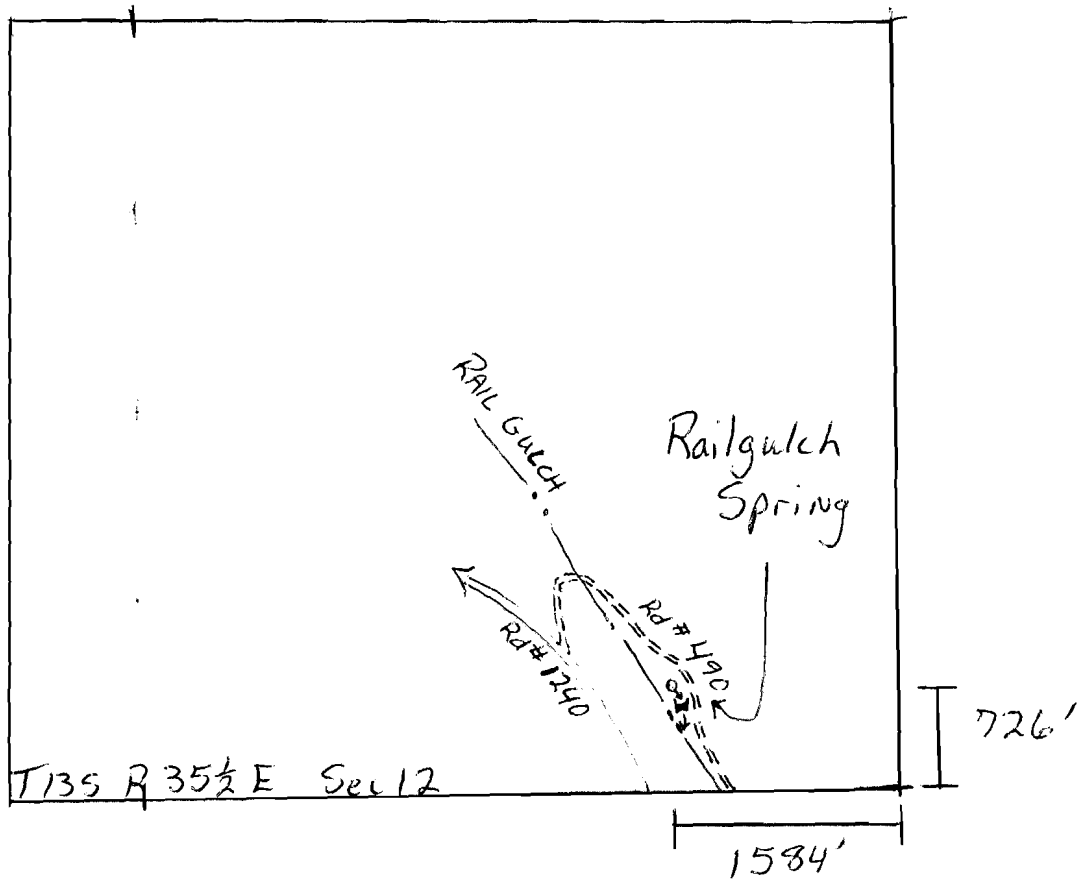

4" = 1 mile



RECEIVED

3 11 1982

LAND RESOURCES DEPT.
SALEM, OREGON

Application No. 65906
Permit No. 50546