


RECEIVED

3 JUN 1983

WATER RESOURCES DEPT.
SALEM, OREGON

Application No. 65907
Permit No. 50547

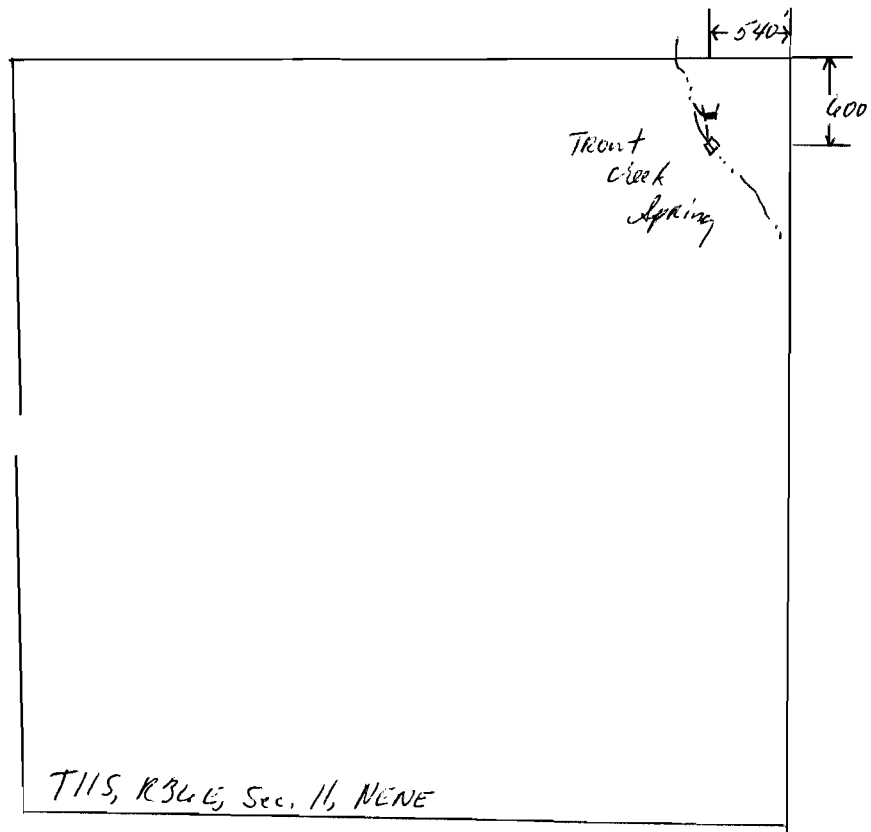

4" = 1 mile

