


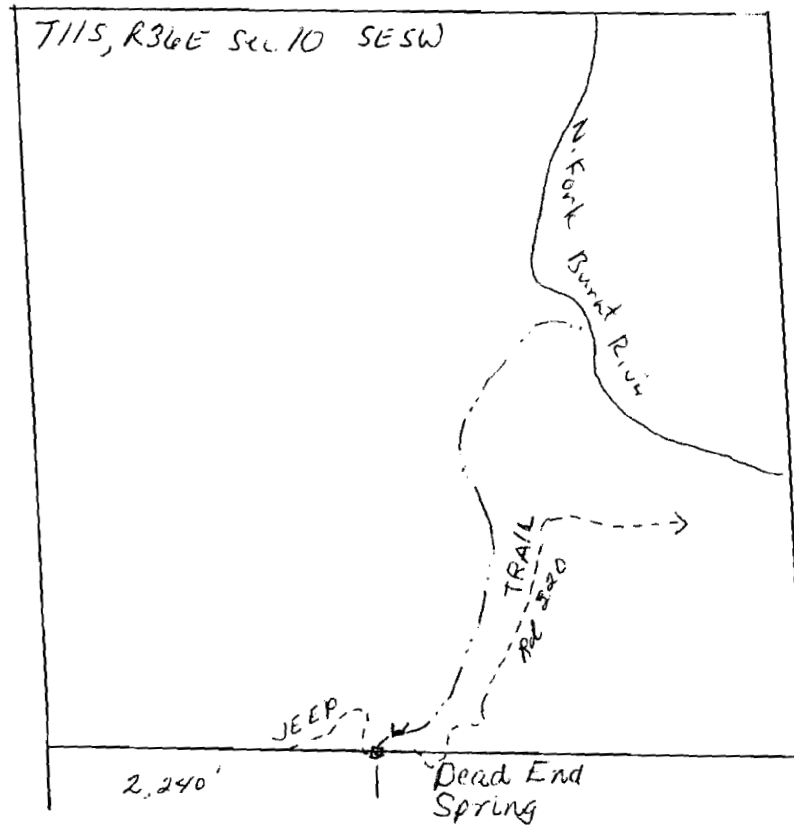

4" = 1 mile

↑ N

RECEIVED

SEP 10 1980

LAND RESOURCES DEPT.
SALEM, OREGON

Application No. 65909
Permit No. 50548