


RECEIVED
SEP 26 1983
LAND RESOURCES DEPT.
SALEM, OREGON

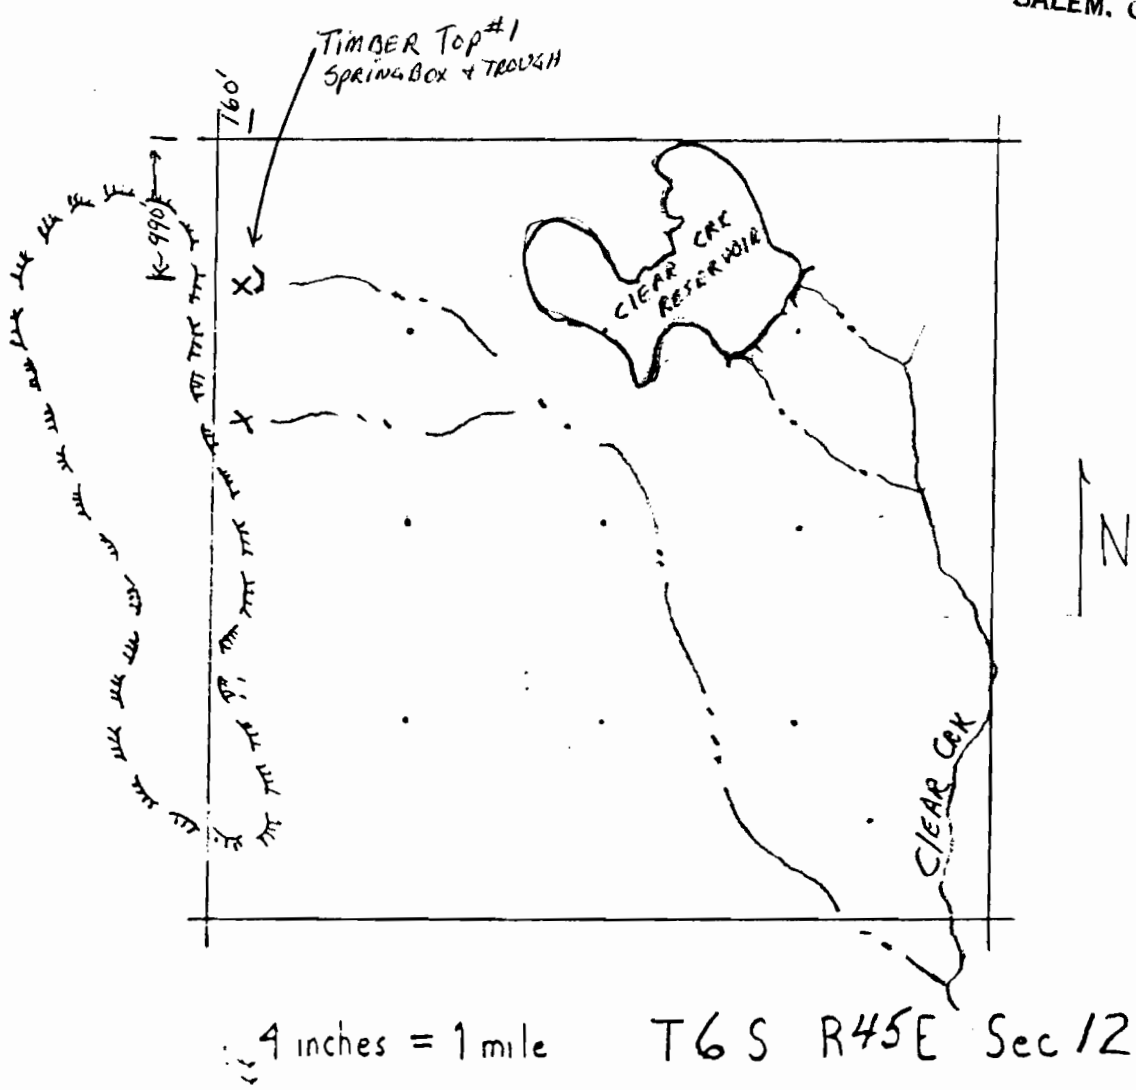

Application No. 66740
Permit No. 50579