



4" = 1 MILE

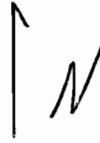

RECEIVED

SEP 26 1983

**WATER RESOURCES DEPT.
SALEM, OREGON**

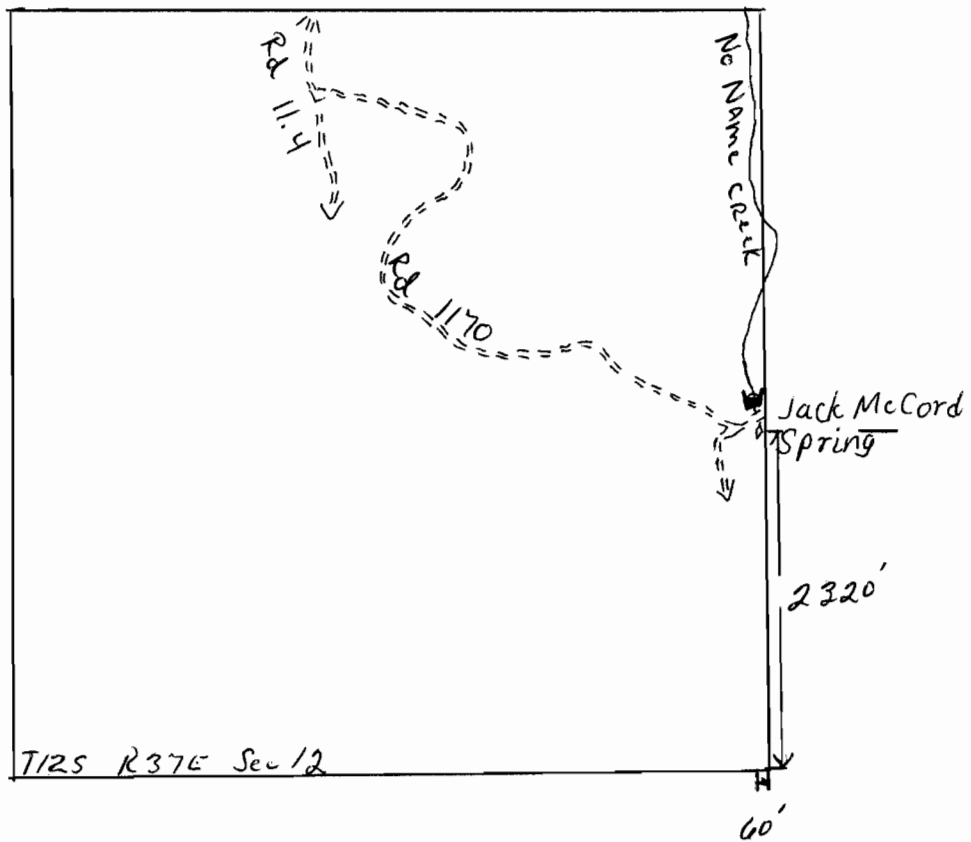

Application No. 66882
Permit No. 50580