


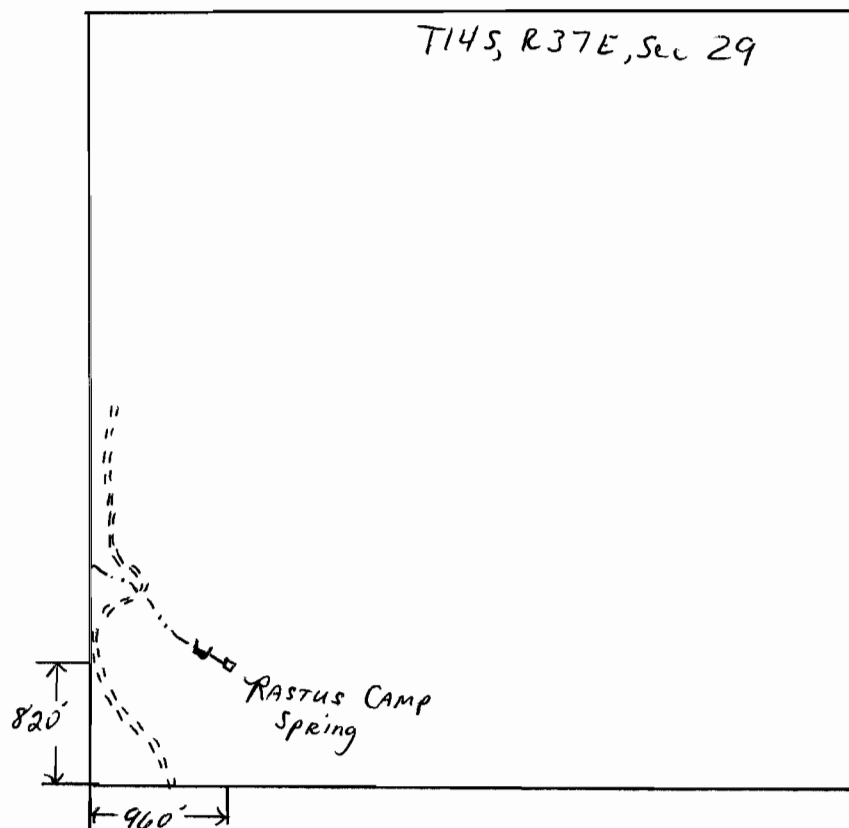

Application No. 66883
Permit No. 50581