


RECEIVED

SE. 3-1933

WATER RESOURCES DEPT.
SALEM, OREGON

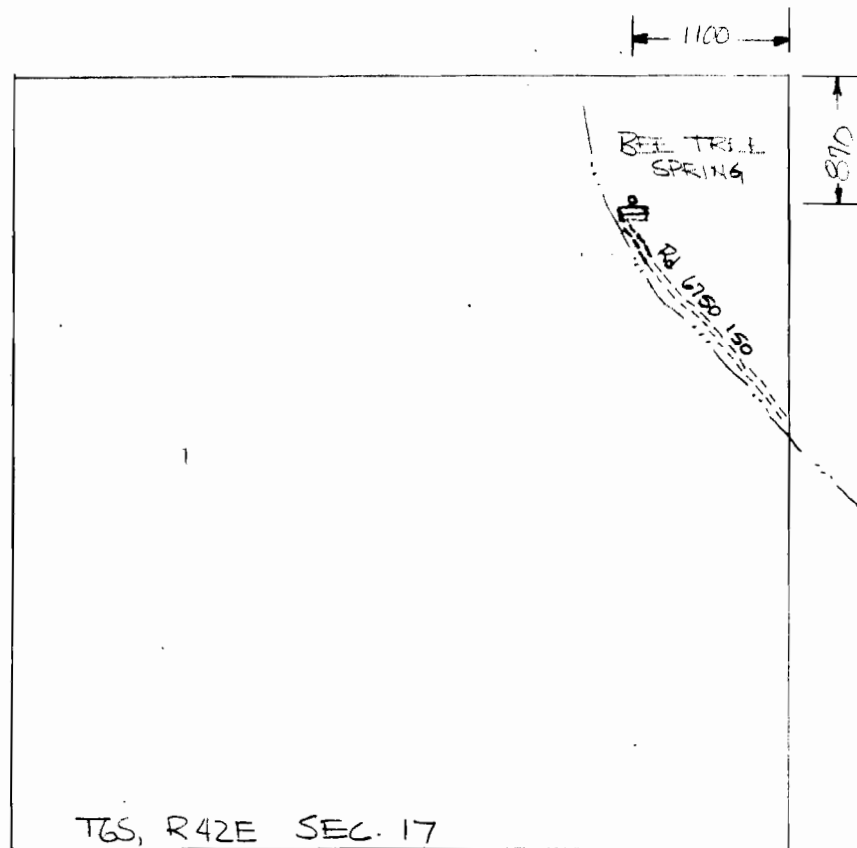

4 INCHES = 1 MILE

N

Application No. 65953
Permit No. 50583