


RECEIVED

SEP 3 1983

WILDERNESS RESOURCES DEPT.
SALEM, OREGON

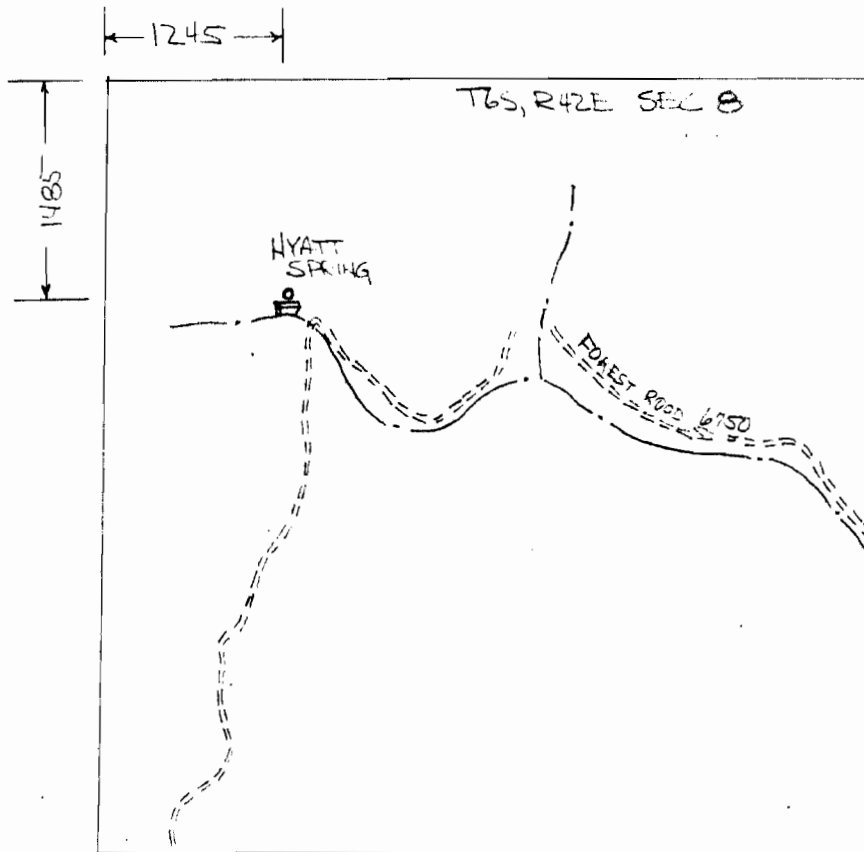

4 INCHES = 1 MILE

↑ N

Application No. 65962
Permit No. 50584