


RECEIVED
SEP 3 1983
WILDERNESS SERVICES DEPT.
SALEM, OREGON

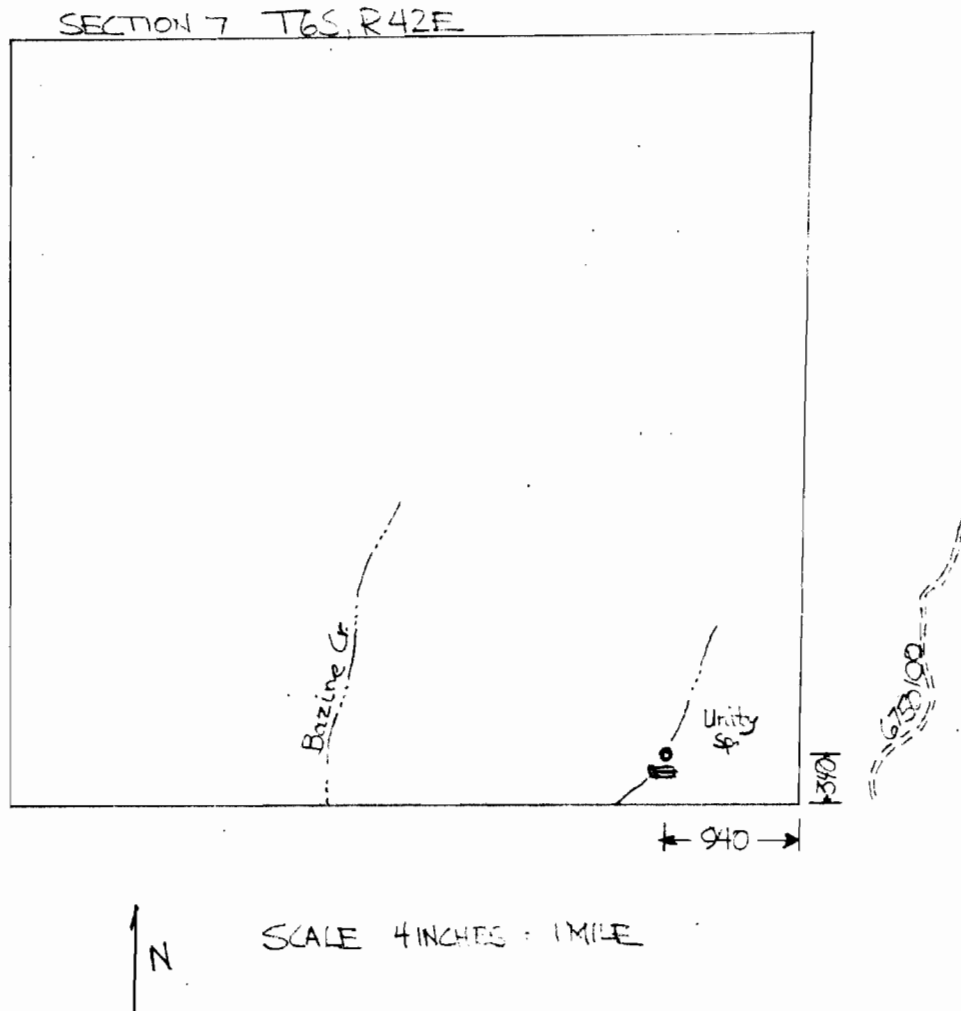

Application No. 65963
Permit No. 50585