
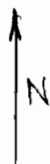


RECEIVED
SEP 3 1933
WILDERNESS DIVISION DEPT.
SALEM, OREGON

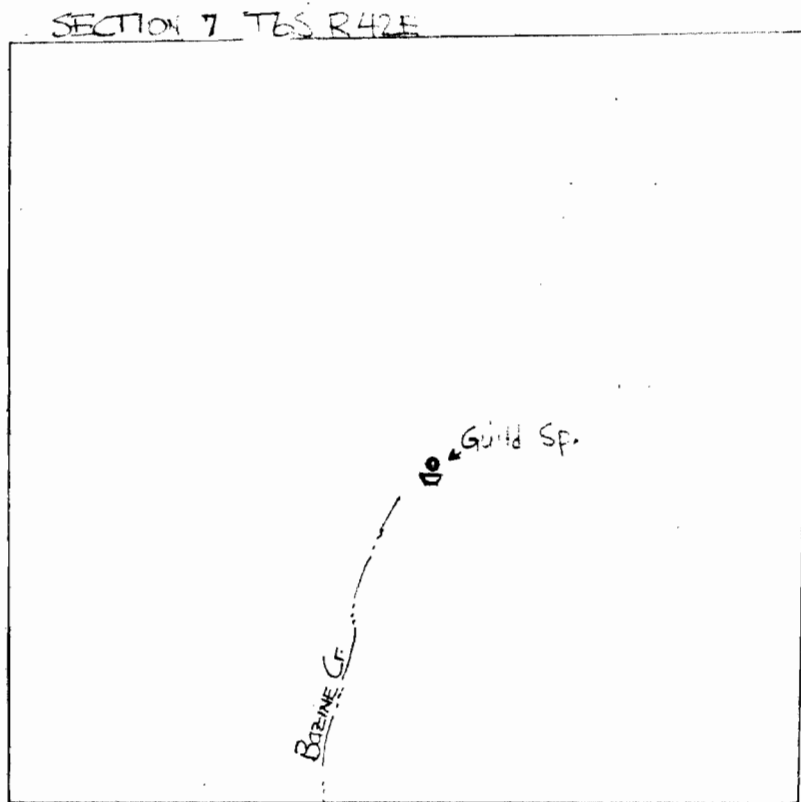

SCALE 4 INCHES = 1 MILE

Application No. 65964
Permit No. 50586