


MAP  
OF  
W. F. JACKSON  
WATER SYSTEM

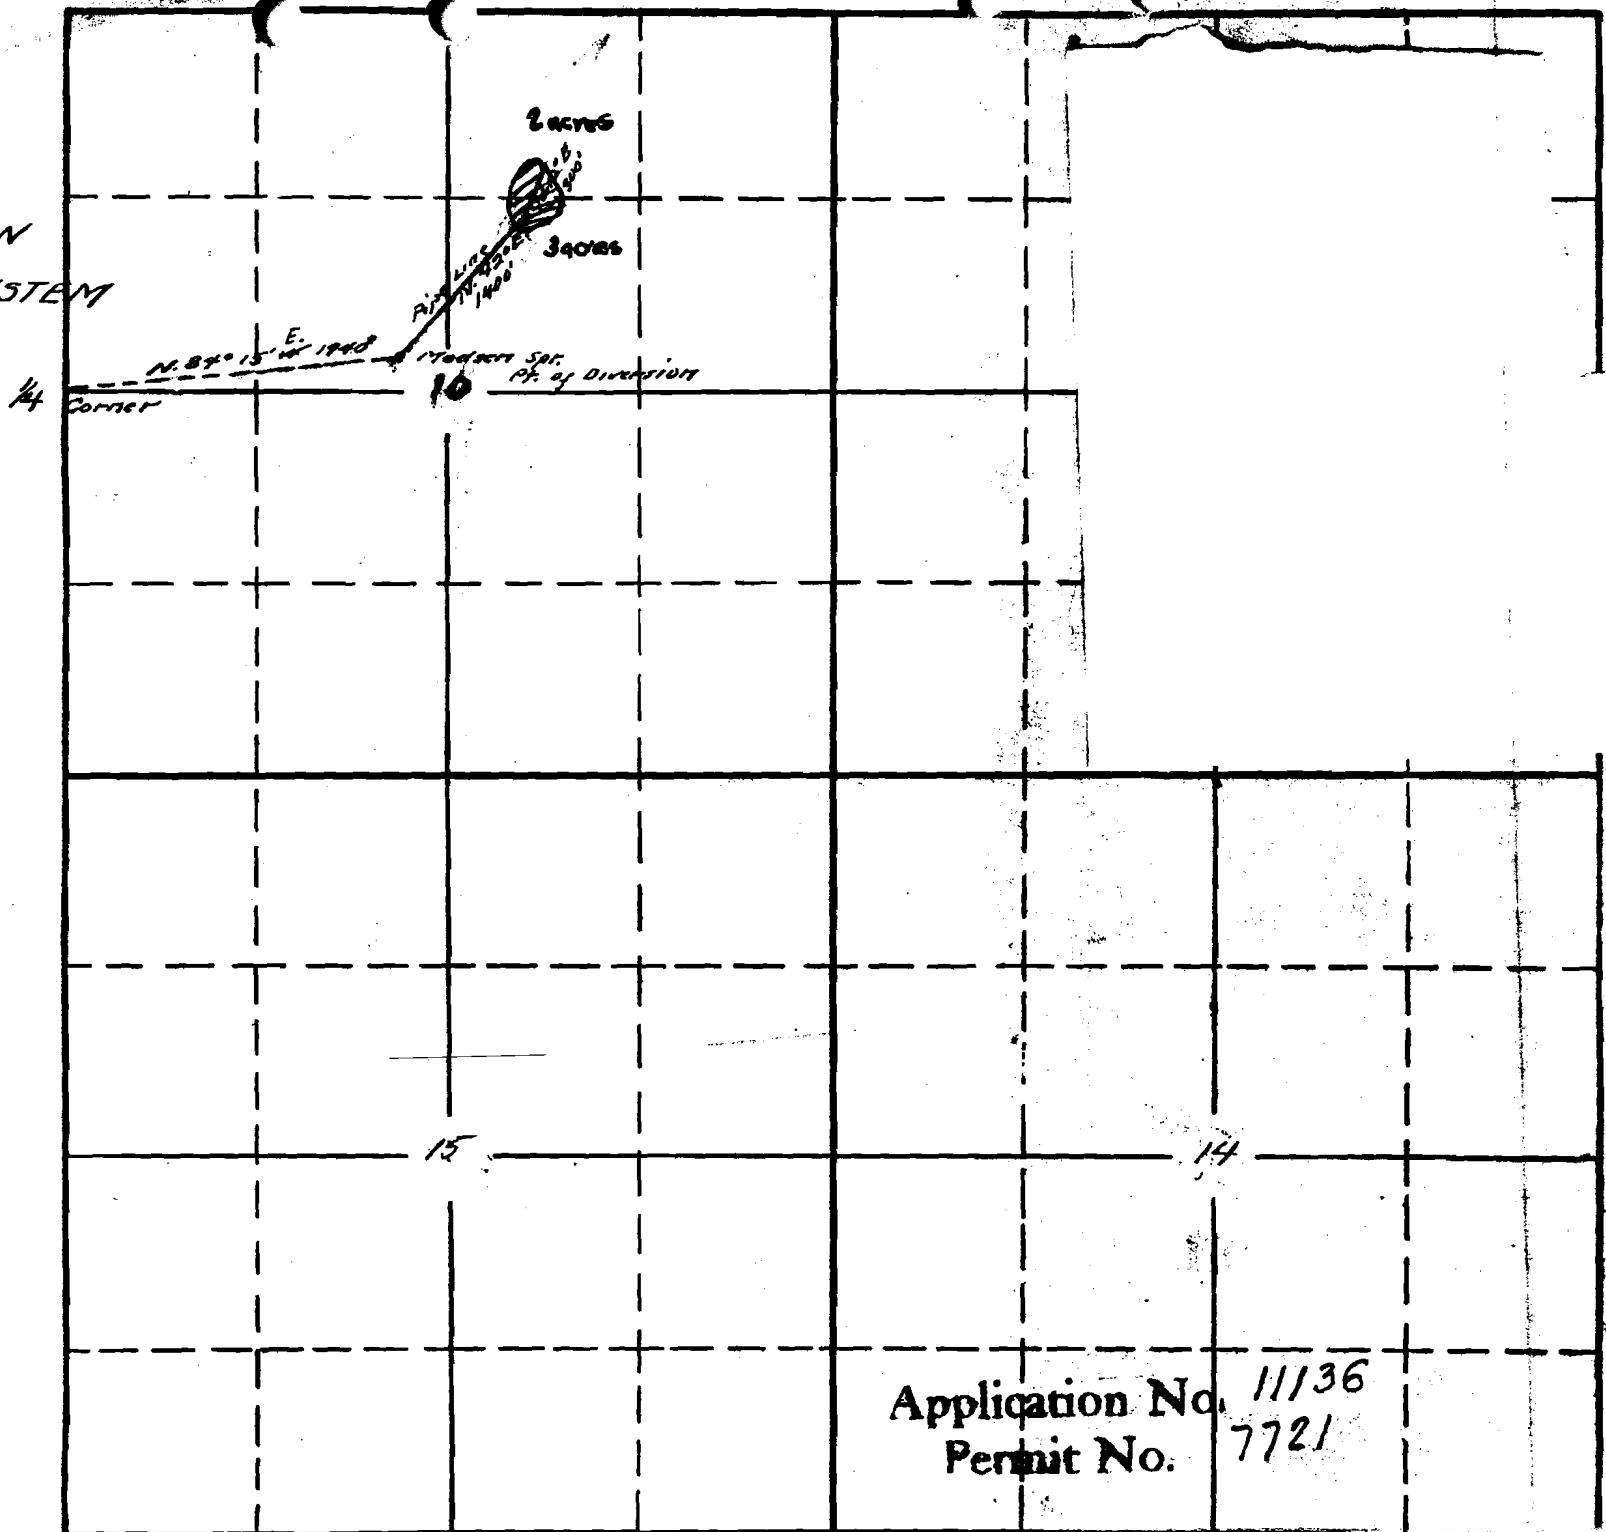

Sec. 10  
\_\_\_\_\_  
\_\_\_\_\_  
\_\_\_\_\_  
Tp. 13 S.  
R. 9 E.

Application No. 11136  
Permit No. 7721

7721  
C-7812