



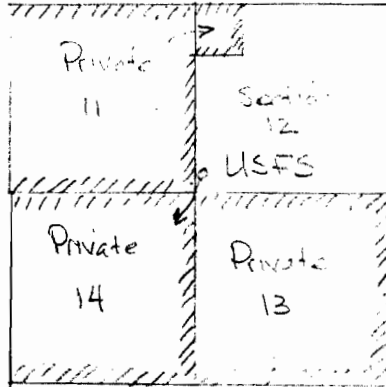

SEP 3 1933  
 FOREST SERVICE DEPT.  
 SALEM, OREGON

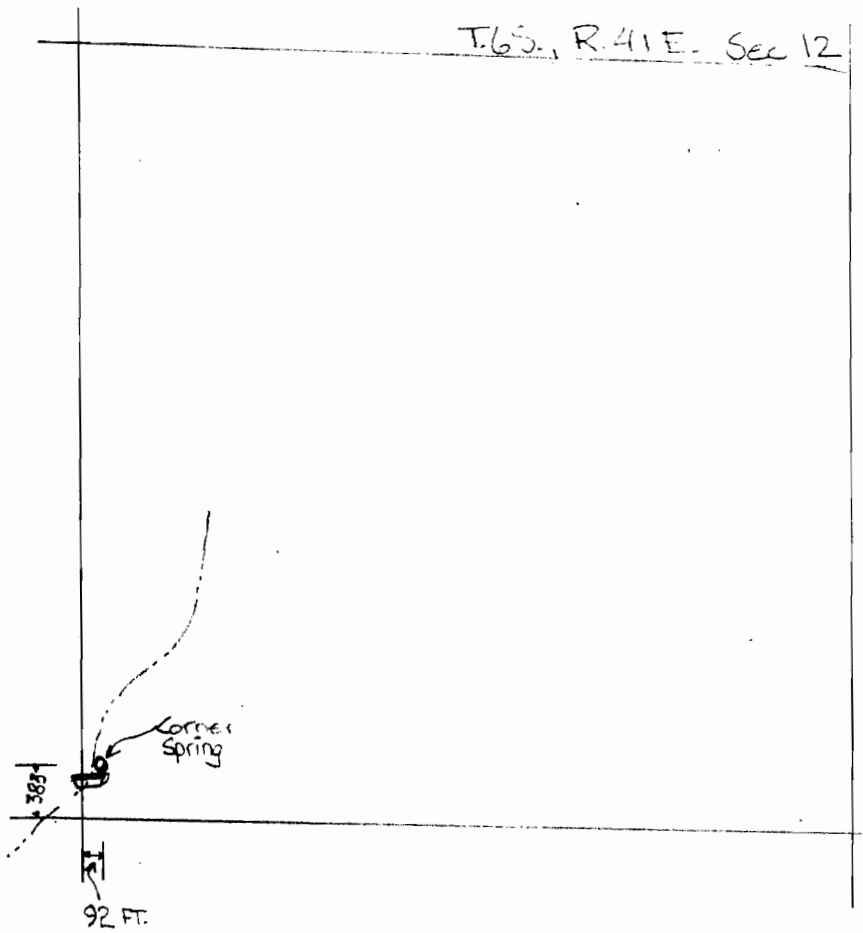

HWY  
 203

Application No. 65967  
 Permit No. 50587