


RECEIVED

SEP 26 1983
WATER RESOURCES DEPT.
SALEM, OREGON

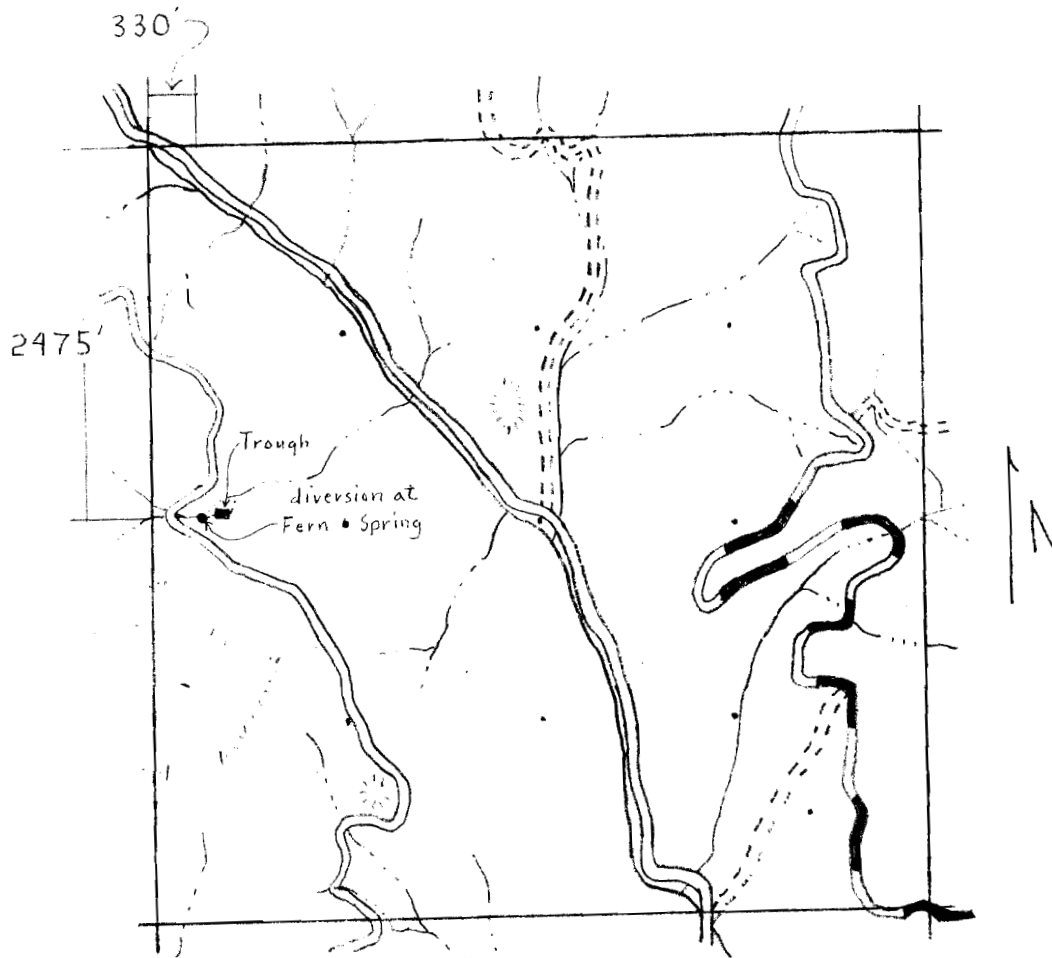

4 inches = 1 mile T7S R43E Sec 3

Application No. 66748
Permit No. 50618