


RECEIVED

SEP 26 1983

SALEM, OREGON

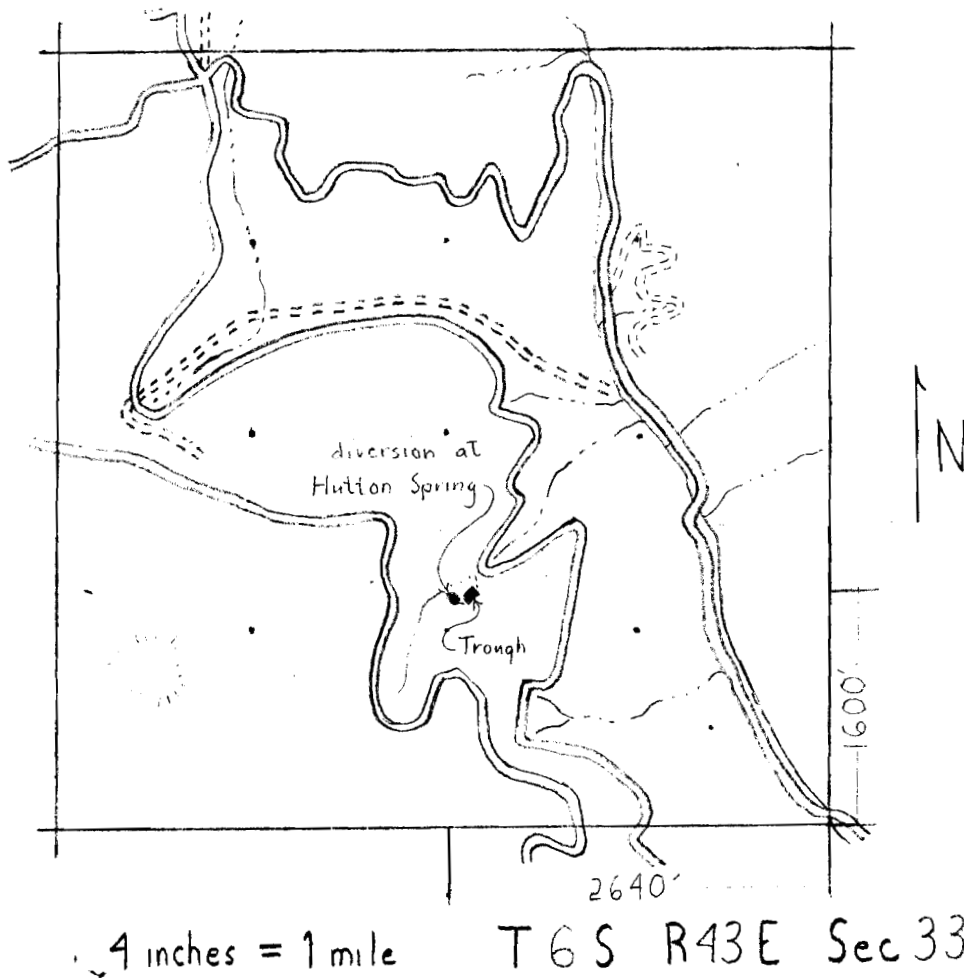

Application No. 66749
Permit No. 50619

USFS # 7-7365