


T 9 S R37 E W.M.

Section N26

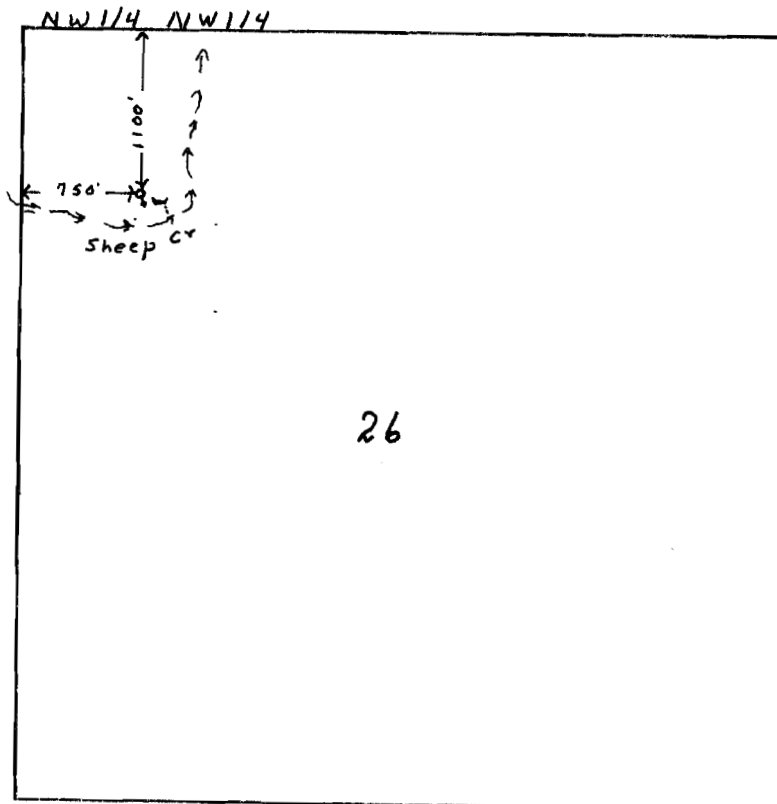

Sheep Trail Spr.

Scale 4" = 1 mile

Application No. 65719

Permit No. 50628

RECEIVED

APR 29 1988

WATER RESOURCES DEPT
SALEM, OREGON

RECEIVED

APR 29 1988