


T 9 S R 38 E W.M.

Section 15

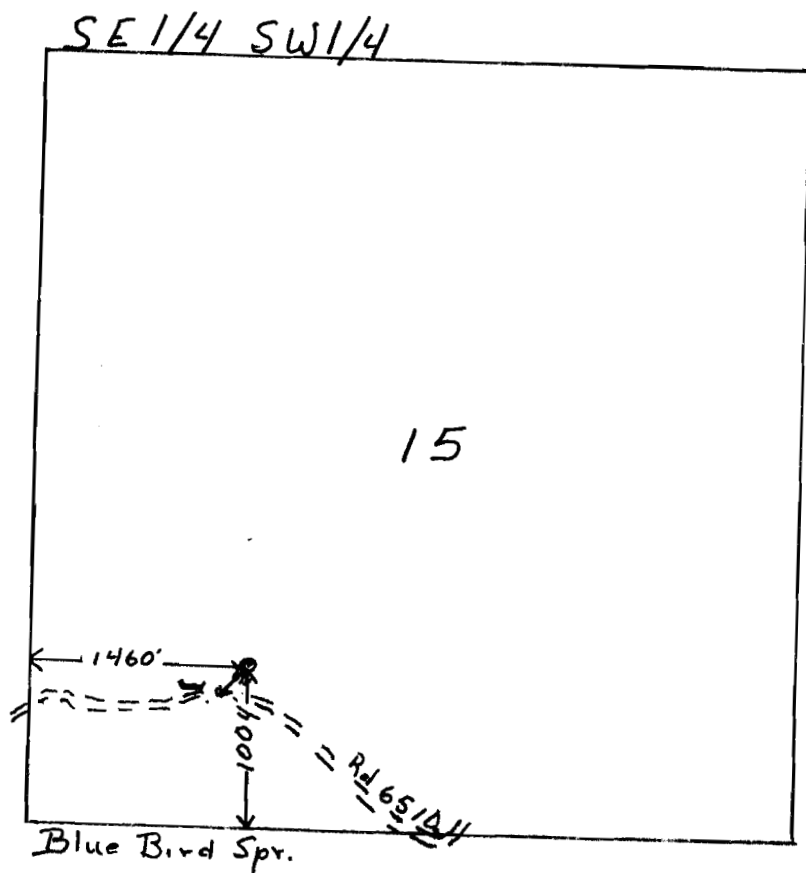

Scale 4" = 1 mile

Application No. 65723

Permit No. 50629

RECEIVED

APR 9 1981

LAND RESOURCES DEPT
SALEM, OREGON