


SECTION 24 T6S, R42E

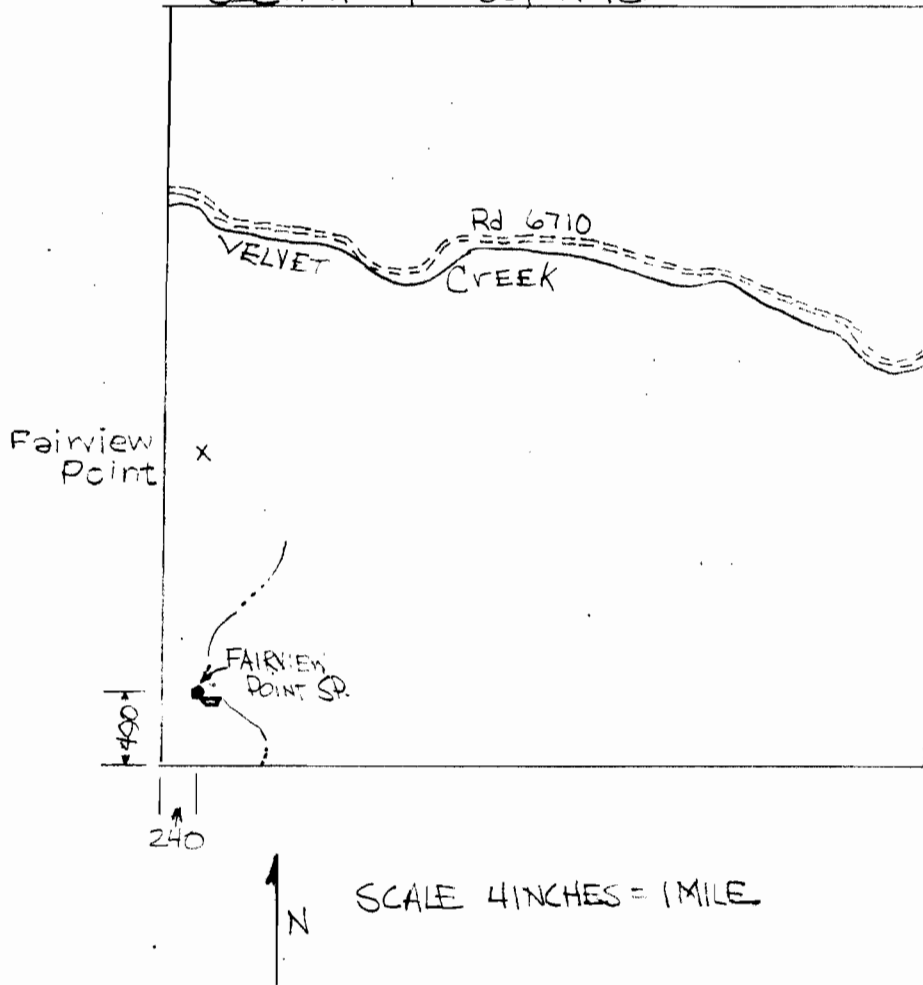

RECEIVED

SEP 3 1933  
LAND RESOURCES DEPT.  
SALEM, OREGON

Application No. 65960  
Permit No. 50632