


RECEIVED

SEP 3 1983

WATER RESOURCES DEPT.
SALEM, OREGON

Colton Spring

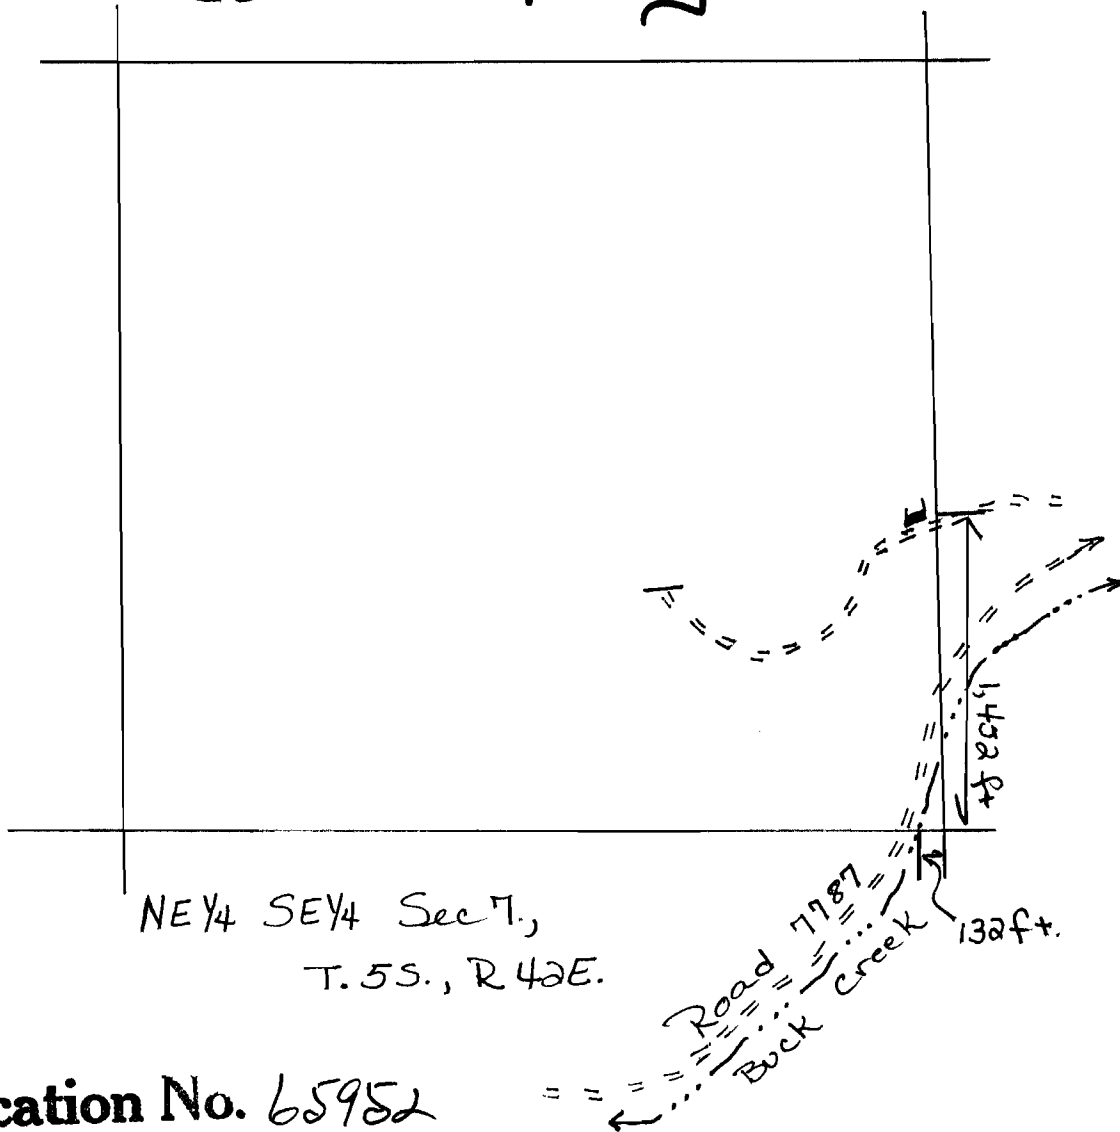

Application No. 65952
Permit No. 53135

Scale:
4 inches = 1 mile

