

Catherine Creek


RECEIVED

SEPS 1983

WATER RESOURCES DEPT.

SALEM, OREGON

Camp Creek Trail Spring

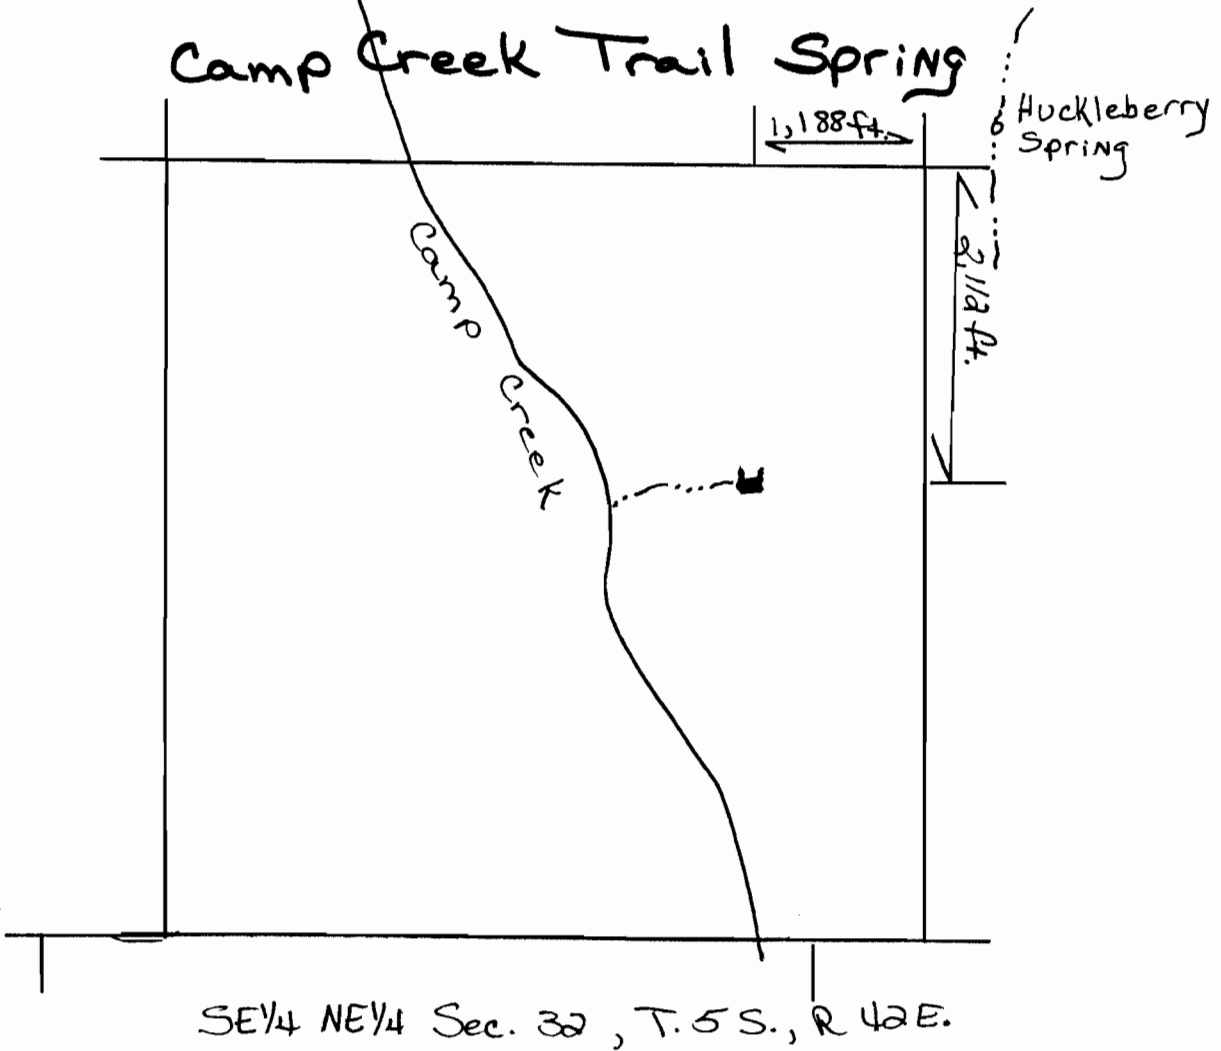

↑ N

Scale:
4 inches = 1 mile

Application No. 65948

Permit No. 53137

