


RECEIVED

SEP 26 1983

U.S. FOREST SERVICE DEPT
SALEM, OREGON

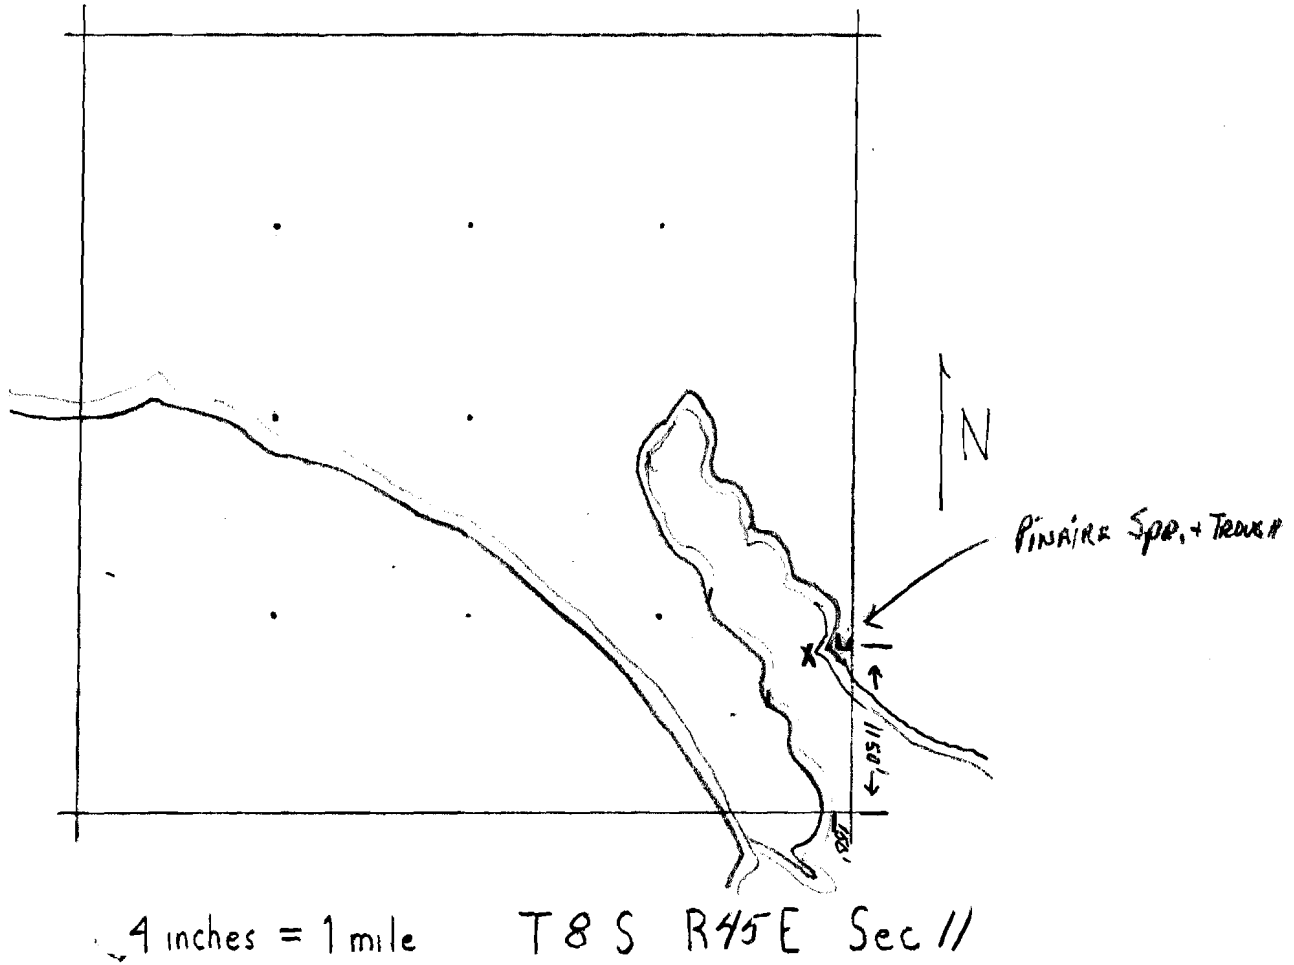

Application No. 66743
Permit No. 53138

USFS# 7-7401