
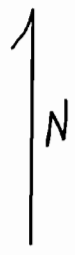


Application No. 65944
Permit No. 53139

RECEIVED
SEP 6 1983
WATER RESOURCES DEPT.
SALEM, OREGON

Cut-Off Trough

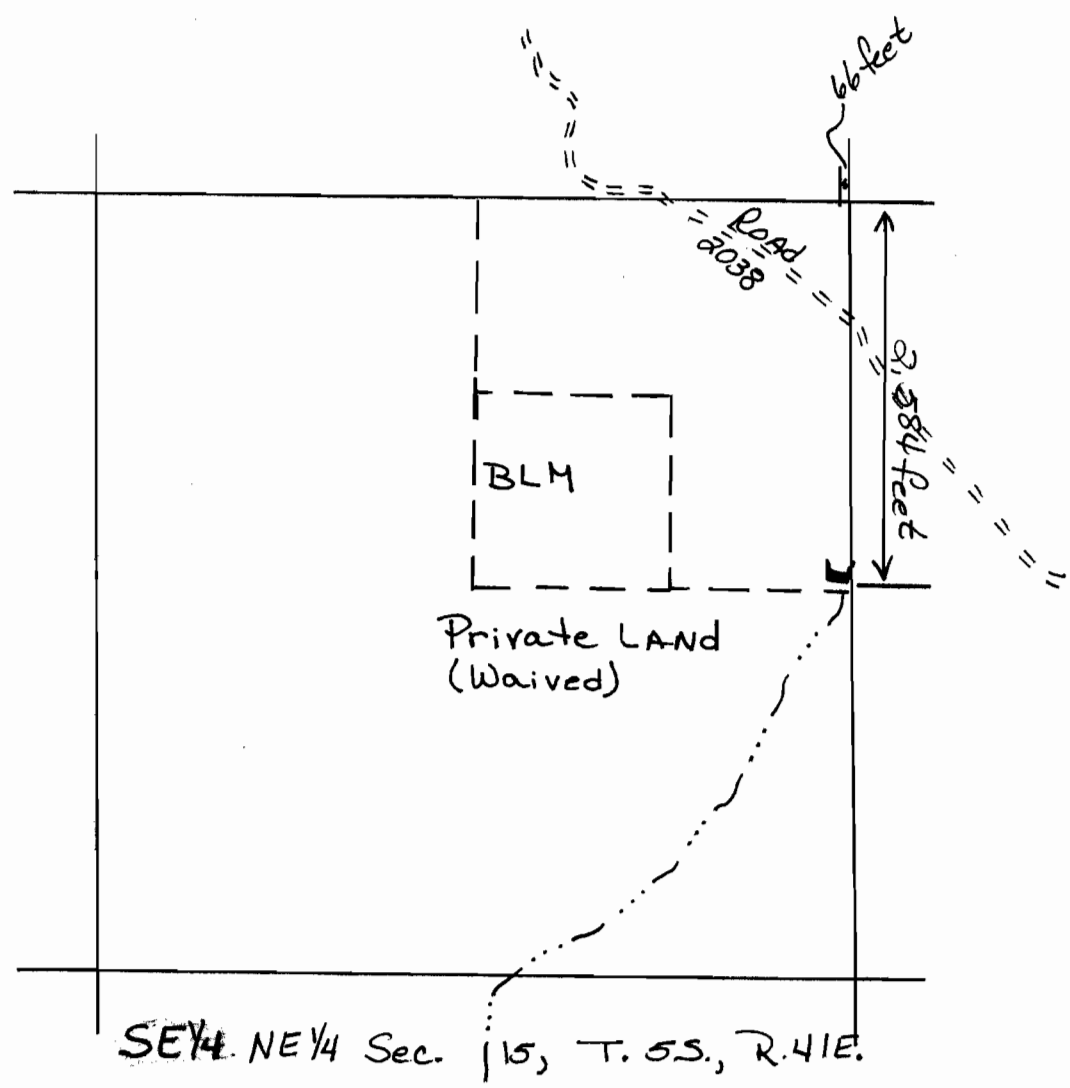

4 inches = 1 mile