


RECEIVED

SEP 6 1983

WATER RESOURCES DEPT.
SALEM, OREGON

Highway Spring

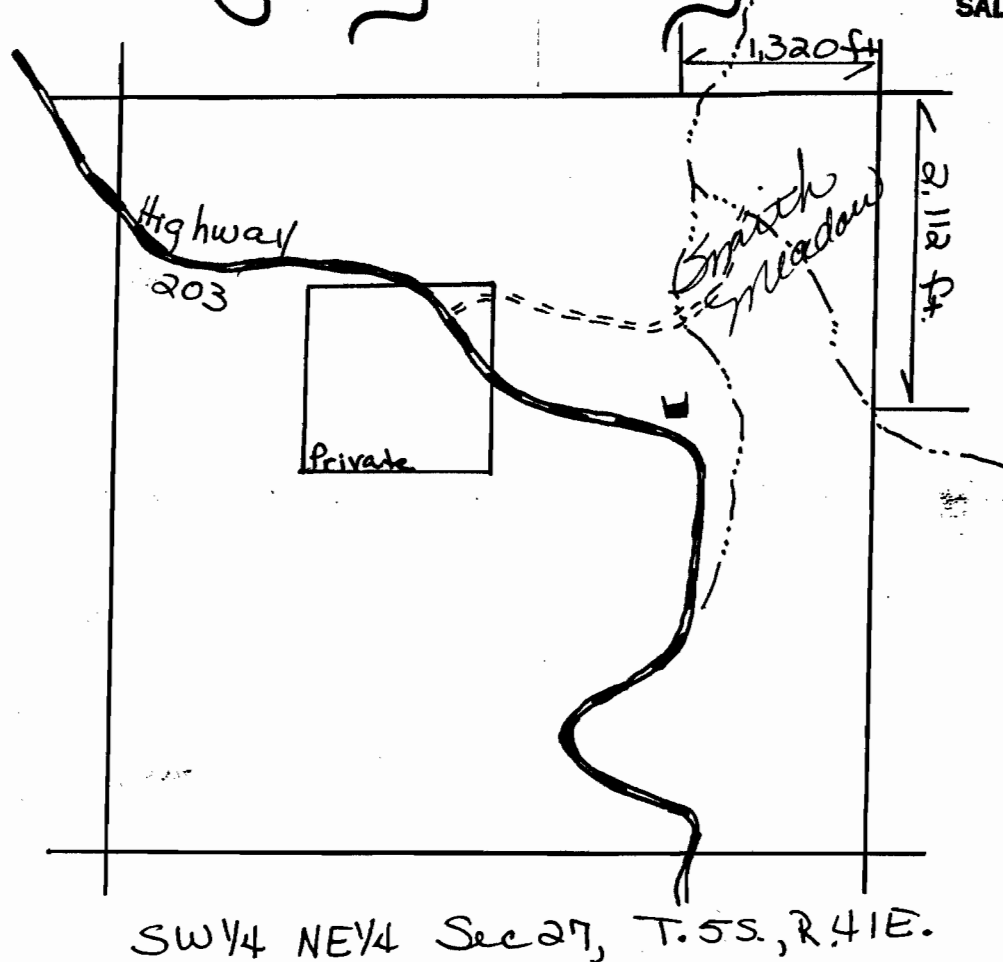

Application No. 65946
Permit No. 53140

Scale:
4 inches = 1 mile

