


Application No. 65908
Permit No. 53141

RECEIVED

JUL 1 1933

LAND RESOURCES DEPT.
SALEM, OREGON

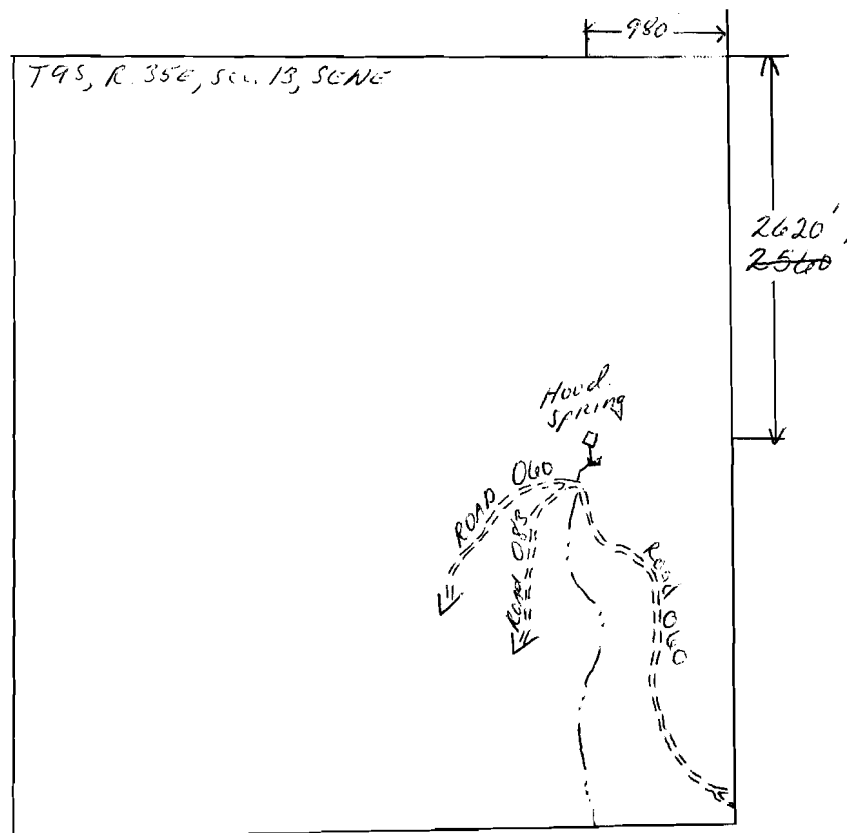

4" = 1 MILE

N