


RECEIVED

SEP 6 1983

WATER RESOURCES DEPT.
SALEM, OREGON

Frazier Trough

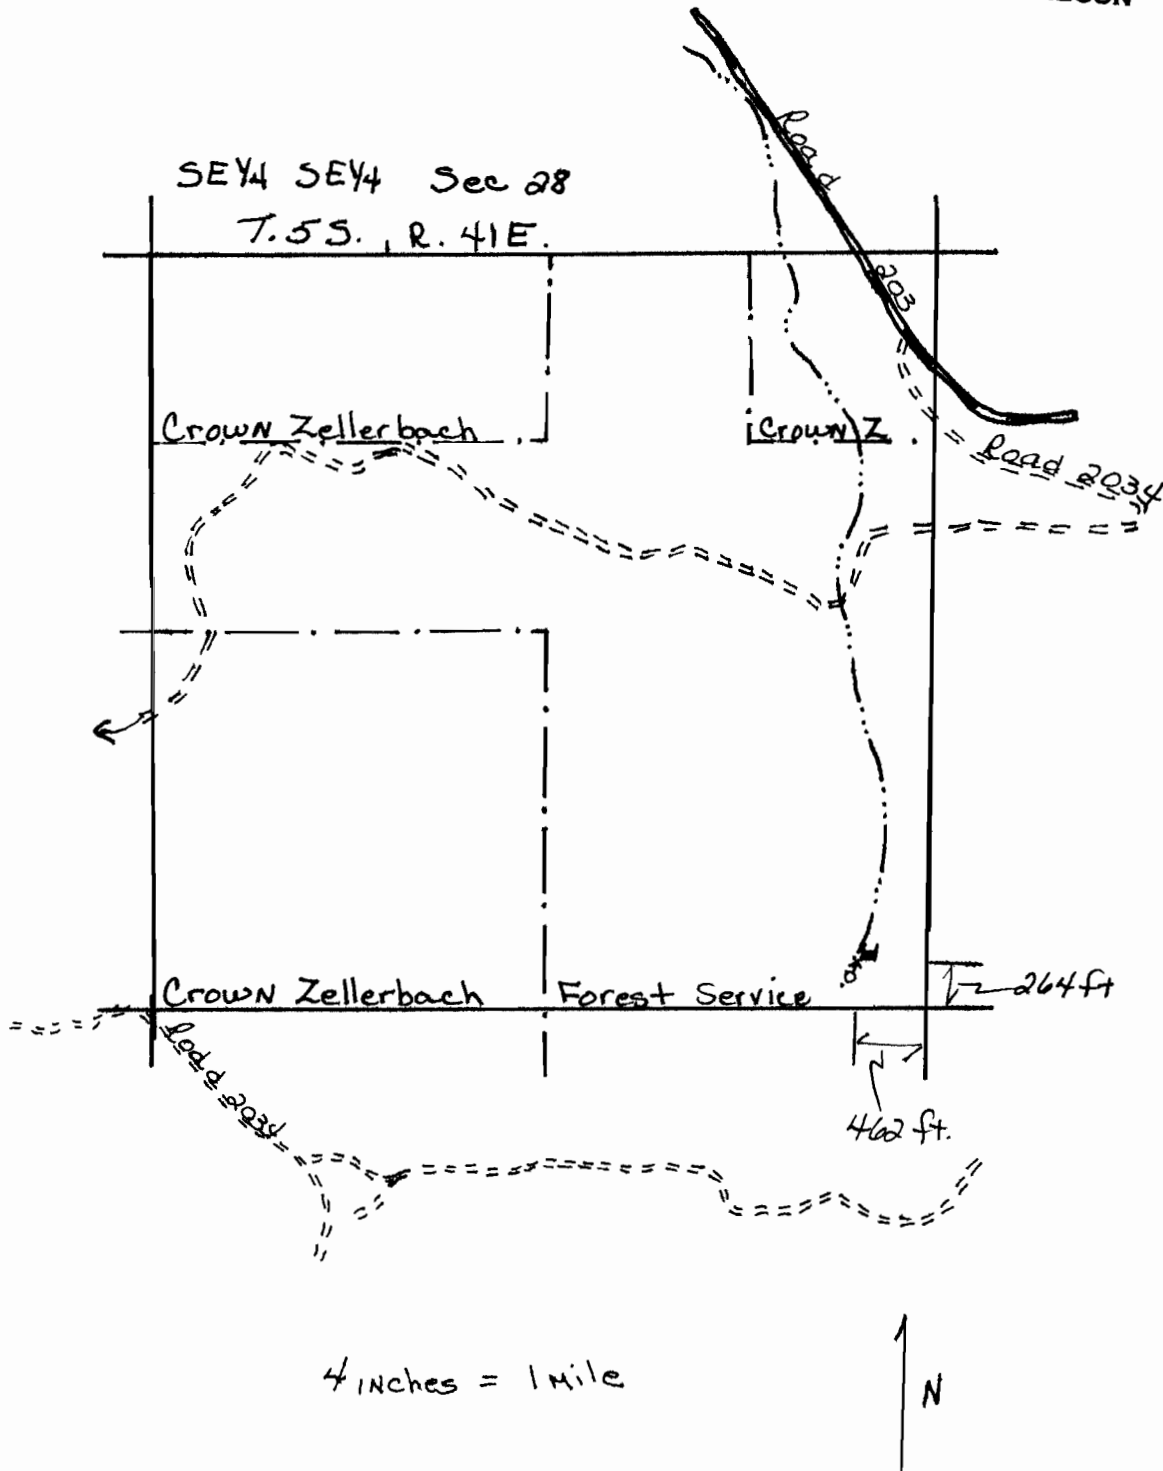

Application No. 65947

Permit No.

53142